#### November 10, 2015

### BALDWIN COUNTY PROJECT NO. 0218014 REPLACE CROSSDRAINS DAMAGED FROM 04/29/2014 RAIN EVENT

#### ADDENDUM NO. 1

#### TO ALL BIDDERS ON THE ABOVE REFERENCED PROJECT:

Sheet 2-2G, 3-3B, and 37 of the Plans have been revised and are attached to this addendum.

A summary of the **change(s)** to the Plan Sheets Includes:

#### Sheet 2-2F: "Typical Sections

o Detail of Typical Pipe Joint was added.

Please replace Sheet 2-2F, Typical Sections, in the plans.

#### Sheet 2G: "Project Notes"

o Note 703 where it states BC300-224 should state BC300-024.

Please replace Sheet 2G, Project Notes, in the plans.

## Sheet 3-3B: "Summary of Quantities"

- o Pay Item No. 737A-000 Dynamic Message Sign, Quantity 4, is being removed.
- o Pay Item No. 742A-003 Portable Changeable Message Sign, Type 3, Quantity 4, is being added.

Please replace Sheet 3-3B, Summary of Quantities, in the plans.

#### Sheet 37: "Traffic Control Plan – Sequence of Construction"

o Note 703 where it states BC300-224 should state BC300-024.

Please replace Sheet 37, Traffic Control Plan – Sequence of Construction, in the plans.

Item I, ADVERTISEMENT FOR BIDS, in the Documents and Construction Specifications has been revised and is attached to this addendum.

 ONE HUNDRED TWENTY (150) CALENDAR DAYS changed to read ONE HUNDRED FIFTY (150) CALENDAR DAYS

Item III, PROPOSAL, in the Documents and Construction Specifications has been revised and is attached to this addendum.

- ONE HUNDRED TWENTY (150) CALENDAR DAYS changed to read ONE HUNDRED FIFTY (150) CALENDAR DAYS
- o Pay Item No. 737A-000 Dynamic Message Sign, Quantity 4, is being removed.
- o Pay Item No. 742A-003 Portable Changeable Message Sign, Type 3, Quantity 4, is being added.

Please replace the sheets that include the ADVERTISEMENT & PROPOSAL in the Documents and Construction Specifications with the attached new sheets for the ADVERTISEMENT & PROPOSAL for the above referenced project.

The bidders on this project will be required to return a signed copy of this Addendum to Matthew S. Brown (FAX: 251-937-0201 or EMAIL: msbrown@baldwincountyal.gov) or Stacy Appleton, (sappleton@baldwincountyal.gov) prior to Monday, November 16, 2015 at 2:00 A.M.

If you have any questions regarding this addendum, please call. A copy of this addendum, signed by the contractor's representative must accompany each bid.

Sincerely,	SIGNED:
CAL MARKERT, P.E. COUNTY ENGINEER	Contractor's Representative
By: Matthew/S. Brown Design Engineer	Date
	Company



# **BALDWIN COUNTY**

HIGHWAY DEPARTMENT

CAL MARKERT, P.E. COUNTY ENGINEER

P.O. Box 220

SILVERHILL, ALABAMA 36576

TELEPHONE: (251) 937-0371 FAX (251) 937-0201

# Utility Information for: BCP# 0218014 (Anchor Sites)

**Culvert Restorations** 

<u>Statement</u>: The following information should only be used for informational purposes; utilities shall be checked by the contractor on site to verify current site conditions. The following information was compiled to the best of our knowledge but it is the responsibility of the contractor to determine actual conditions.

#### Color Guide:

0

0

Green sites have no known utility conflicts

Yellow sites have not yet been determined

Red sites have known utility conflicts

#### BC300-014 - CR 91

Perdido Bay Water – Has a 6" main 23' from EOP @ 14" deeper that the existing pipe. They do not think it will be in conflict.

Century Link has a 50 pair on the west side and a 50 pair on the east side. Conflict not determined.

#### BC300-024 - CR 97

Baldwin County Sewer has an 8" sewer main on the east side of the road. They say this line was bored and is deep enough it should not be in conflict.

Century Link has a 50 pair on the east side. Conflict not determined.

#### BC300-043 - CR 20

Century Link has a 25 pair on the east side. Conflict not determined.

#### BC300-051 - CR 87

Baldwin county Sewer has a 4" sewer main on the east side of the road. They say this line was bored and is deep enough it should not be in conflict.

Century Link has a 100 pair on the east side. Conflict not determined.

#### BC300-052 - CR 87

Baldwin County Sewer has a 4" sewer main on the east side of the road. They say this line was bored and is deep enough it should not be in conflict.

Century Link has a 100 pair on the east side. Conflict not determined.

#### BC300-053 - Stucki Rd

Century Link has a 25 pair on the west side. Conflict not determined.

#### BC300-055 - Feely Rd

Baldwin County Sewer has a 4" sewer main on the east side of the road. They say this line was bored and is deep enough it should not be in conflict.

Century Link has a 50 pair on the north side. Conflict not determined.

#### BC300-112 - CR 95

Baldwin County Sewer has a 4" sewer main on the east side of the road. They say this line was bored and is deep enough it should not be in conflict.

Century Link has a 300 pair on the east side. Conflict not determined.

#### BC300-118 - CR 95

Baldwin County Sewer has an 8" sewer main on the west side of the road, conflict not determined.

Riviera has a 4" gas main on the east side of the road. It is about 3' deep and 19' from the edge of pavement. Conflict not determined.

Century Link has a 50 pair on the east side. They also have an empty conduit for future use on the east side. Conflict not determined.

#### BC300-121 - CR 26

Century Link has a 25 pair on the south side. Conflict not determined.

## BC300-182 - Soldiers Creek Rd

Baldwin County Sewer has a 6" sewer main on the north side of the road. They say this line was bored and is deep enough it should not be in conflict.

Century Link has a 100 pair on the east side. Conflict not determined.

#### BC300-185 - CR 87

Baldwin County Sewer has a 2" sewer main on the north side of the road and was directionally bored and should be deep enough and out of conflict...possibly inactive.

Century Link has a 50 pair on the north side. Conflict not determined.

#### BC300-198 - Wolf Field Rd

Century Link has a 12 pair under the road. Conflict not determined.

#### BC300-208 - Clubhouse Dr

Baldwin County Sewer has a 3" sewer main on the east side of the road close to the back of the right of way and should not be in conflict.

Century Link has 2 – 400 pairs and a fiber line on the east side. Conflict not determined.

#### BC300-224 - Maidmont Ln

O Century Link has a 25 pair on the south side. Conflict not determined.

#### BC300-228 - Fish Trap Rd

Baldwin County Sewer has a 6" sewer main on the south side of the road and on the back of the right of way, conflict not yet determined.

Century Link has a 50 pair on the north side. Conflict not determined.

#### BC300-231 - CR 91

Century Link has a 25 pair on the east side and a 50 pair on the west side. Conflict not determined.

#### BC300-232 - CR 91

Century Link has a 25 pair on the east side and a 50 pair on the west side. Conflict not determined.

#### BC300-246 - Stucki Rd

Century Link has a 150 pair on the west side. Conflict not determined.

#### BC300-248 - CR 95

Baldwin County Sewer has a 4" sewer main on the west side of the road. They say this line was bored and is deep enough it should not be in conflict.

Orange Beach Sewer – Has a 6" sewer main on the west side of the road, conflict not determined

Century Link has a 150 pair on the east side. Conflict not determined.

#### BC300-252 - Hammock Rd

Century Link has 2 – 25 pairs on the east side. Conflict not determined.

#### BC300-283 - CR 20

Riviera has a 2" gas main 21' from edge of pavement. It is in the ditch with the water line. Conflict not yet determined.

Riviera has a water line at the same location as the gas line. Conflict not yet determined.

Century Link has fiber and at least a 300 pair on the north side with possible conflicts. Century Link would like to look at this with the contractor before work begins.

#### ITEM I

## **ADVERTISEMENT FOR BIDS**

Sealed proposals will be received by the Purchasing Department for the Baldwin County Commission, Baldwin County, Alabama, in the offices located at 257 Hand Avenue, Bay Minette, Alabama, 36507, until **2:00 PM on November 16, 2015**, and then publicly opened for furnishing all labor and materials, and performing all work required by Baldwin County and described as follows:

# PROJECT NO. BCP 0218014 REPLACE CROSSDRAINS DAMAGED FROM THE 04/29/2014 RAIN EVENT

ONE HUNDRED FIFTY (150) CALENDAR DAYS are allowed for the construction of the project.

All bids must be on blank forms provided in the Specifications and submitted in its entirety. A cashier's check drawn on an Alabama bank or a Bidder's Bond, payable to Baldwin County, Alabama, for an amount not less than five percent (5%) of the amount bid, but in no event more than ten thousand dollars, shall be filed with the proposal. The bidder's bond shall be prepared on the form specified and signed by a bonding company authorized to do business in the State of Alabama.

A performance bond in the form and terms approved by the County in an amount not less than the contract price will be required at the signing of the contract. A labor and materials bond in the form and terms approved by the County in an amount not less than fifty percent (50%) of the contract price insuring payment for all labor and materials shall also be required at the signing of the contract. In addition, the Contractor must furnish to the County at the time of the signing of the contract a certificate of insurance coverage as provided in the specifications. The right is reserved to reject any and/or all bids and to waive informalities or irregularities and to furnish any item of material or work to change the amount of said Contract.

Liquidated damages for non-completion of the work within the time limit agreed upon will be assessed in accordance with the terms of the contract.

Specifications are on file and may be obtained in the office of the Baldwin County Highway Department, 22070 State Highway 59, Central Annex II, 3<sup>rd</sup> Floor. Plans and specifications may be obtained by contacting Stacy Appleton at 251-972-8564. No specifications will be issued to contractors later than twenty-four (24) hours prior to the time indicated above for receiving bids.

A **Pre-Bid conference** will be held on **November 9, 2015 at 2:00 PM** in the Baldwin County Purchasing Conference Room located at 257 Hand Avenue, Bay Minette, Alabama, 36507. It would be in the best interest of the bidders to have a representative present at the pre-bid conference.

No bids will be considered unless the bidder, whether resident or non-resident of Alabama, is properly qualified to submit a proposal for this construction in accordance with all applicable laws of the State of Alabama. This shall include evidence of holding a current license from the State Licensing Board for General Contractors, Montgomery, Alabama, as required by Chapter

8 of Title 34, of the <u>Code of Alabama</u> (1975). In addition, non-residents of the State, if a corporation or any other entity, shall show evidence of having qualified with the Secretary of State to do business in the State of Alabama, if required by law.

No bid shall be withdrawn for a period of thirty (30) days subsequent to the opening of bids without the consent of the County Commission of Baldwin County, Alabama.

COUNTY COMMISSION OF BALDWIN COUNTY, ALABAMA

CHARLES F. GRUBER
Chairman, Baldwin County Commission

## ITEM III

## **PROPOSAL**

DATE:	
Proposal of, Alabama License No, for replacing ero	ssdrains
damaged from the 04/29/14 rain event, <b>Project No: <u>BCP 0218014</u></b> ; for the performance of all work and the fundamental of all labor and materials required by the Contract terms, specifications, and special provisions.	ırnishing
The specifications are attached hereto and specified and made a part hereof.	
TO: The County Commission of Baldwin County	
Dear Sirs:	
The following proposal is made on behalf ofa others. Evidence of 's authority to submit the proposal is herewith furn	nd no ished.
The proposal is made without collusion on the part of any person, firm, or corporationhas carefully examined the	e plans
for this project and the specifications attached hereto, including the special provisions, and has also persexamined the site of work. On the basis of the specifications and plans,	onally
agrees to complete all the work in <b>ONE HUNDRED FIFTY (150) CALENDAR DAYS.</b>	
understands that the quantities below are approximate only and are su either increase or decrease, and hereby proposes to perform any increased or decreased quantities of wor price bid, subject to adjustments as specified in Section 104 of the Alabama Department of Transportation Specifications for Highway Construction, 2012 Edition manual.	k at the
further proposes to perform all "Force Account or Extra Work" that required ofon the basis provided in the Specifications attached and to give such work the personal attention necessary in order to see that it is economically and timely perform	hereto,
further proposes to execute the attached Contract as soon as the work is awarded to and to begin and complete the work within the respective time limit provided for Specifications and Notice to Contractors hereto attached.	
also proposes to furnish a Contract Performance Bond, approte the Owner, in an amount equal to the total amount of the bid. This bond shall serve not only to guarantee completion of the work on''s part, but also to guarantee the excellence workmanship and materials until the work is finally accepted.	ntee the
encloses a cashier's check for	
Dollars  \$or bid bond in the form specified for five (5%) percent of sbid (not to exceed \$10,000.00 Dollars) and hereby agrees that, in case of sfailure to execute a Contract and furnish Bond within 10 da	
from the principal or the sureties, if the guaranty be a bid bond, the difference between the amount of the cor awarded and the amount of the proposal of the next lowest bidder. If no other bids are received, the full and the proposal guaranty shall be so retained or recovered as liquidated damages for such default. It is understo in case the work is not awarded to, the check will be returned as prov	recover ntract as nount of ood that,

Signature of Bidder (If Firm or Individual)	
	By:
Address of Bidder	
*********	*****************
	***
Signature of Bidder (Corporation)	
	Business Address
President	
	Business Address
Secy. & Treas.	
Attest:	
(Corporate Seal)	State

the Specifications hereto attached.

#### PROJECT NO. BCP 0218014

The following items shall be constructed in accordance with the *Alabama Department of Transportation Standard Specifications for Highway Construction*, 2012 Edition, except as modified herein:

#### NOTES:

- 1. The following unit prices shall include all labor, materials, equipment rental, overhead, profit, insurance, costs, expenses, etc., to cover the finished work.
- 2. The Bidder understands that the Owner reserves the right to reject any and all bids.
- 3. The Bidder understands that he must submit this entire booklet with the bid.


ITEM	DESCRIPTION	QTY	UNIT	UNIT PRICE	AMOUNT
206C023	REMOVING RIP RAP	395	SQ YD		
206D000	REMOVING PIPE	970	LF		
206E000	REMOVING HEADWALLS	10	EA		
210A000	UNCLASSIFIED EXCAVATION	6190	CU YD		
210C000	MUCK EXCAVATION & REMOVAL	690	CU YD		
210D022	BORROW EXCAVATION (LOOSE TRUCKBED MEASUREMENT) (A-2-4(0) OR A-4(0)	6190	CU YD		
214A001	FOUNDATION BACKFILL, COMMERCIAL	715	CU YD		
215B000	COFFERDAMS OR SHEETING AND SHORING	14	EA		
230A000	ROADBED PROCESSING	30	RDST		
301A012	CRUSHED AGGREGATE BASE COURSE, TYPE B, PLANT MIXED, 6" COMPACTED THICKNESS	2580	SQ YD		
401A000	BITUMINOUS TREATMENT A	1240	SQ YD		
424A340	SUPERPAVE BITUMINOUS CONCRETE WEARING SURFACE LAYER 1/2" MAXIMUM AGGREGATE SIZE MIX, ESAL RANGE A/B (220 LBS/SY)	492	TON		
424B666	SUPERPAVE BITUMINOUS CONCRETE LOWER BINDER LAYER 1" MAXIMUM AGGREGATE SIZE MIX, ESAL RANGE A/B (300 LBS/SY)	703	TON		

430B003	AGGREGATE SURFACING (ALDOT #57)	500	TON	
502A000	STEEL REINFORCEMENT	27231	LBS	
530A003	30" ROADWAY PIPE (CLASS 3 R.C.)	40	LF	
530A004	36" ROADWAY PIPE (CLASS 3 R.C.)	80	LF	
530A006	48" ROADWAY PIPE (CLASS 3 R.C.)	520	LF	
530A007	54" ROADWAY PIPE (CLASS 3 R.C.)	120	LF	
530A008	60" ROADWAY PIPE (CLASS 3 R.C.)	80	LF	
530B003	36" SPAN, 23" RISE ROADWAY PIPE (CLASS 3 R.C.)	120	LF	
530B004	44" SPAN, 27" RISE ROADWAY PIPE (CLASS 3 R.C.)	392	LF	
530B006	59" SPAN, 36" RISE ROADWAY PIPE (CLASS 3 R.C.)	480	LF	
530B008	73" SPAN, 45" RISE ROADWAY PIPE (CLASS 3 R.C.)	104	LF	
600A000	MOBILIZATION	1	LS	
610C001	LOOSE RIPRAP, CLASS 2	1410	TON	
610D003	FILTER BLANKET, GEOTEXTILE	1410	SQ YD	
619A004	30" ROADWAY PIPE END TREATMENT, CLASS 1	1	EA	
619A204	36" ROADWAY PIPE END TREATMENT, CLASS 1 (DOUBLE LINE)	2	EA	
619A207	48" ROADWAY PIPE END TREATMENT, CLASS 1 (DOUBLE LINE)	1	EA	
619A209	60" ROADWAY PIPE END TREATMENT, CLASS 1 (DOUBLE LINE)	1	EA	
619A308	54" ROADWAY PIPE END TREATMENT, CLASS 1 (TRIPLE LINE)	1	EA	
619A266	48" ROADWAY PIPE END TREATMENT, CLASS 1 (FOUR LINE)	1	EA	
619A276	48" ROADWAY PIPE END TREATMENT, CLASS 1 (TRIPLE LINE)	1	EA	

619B019	44" SPAN, 27" RISE ROADWAY PIPE END TREATMENT, CLASS 1	3	EA	
619B023	73" SPAN, 45" RISE ROADWAY PIPE END TREATMENT, CLASS 1	1	EA	
619B318	44" SPAN, 27" RISE ROADWAY PIPE END TREATMENT, CLASS 1 (FOUR LINE)	2	EA	
619B271	59" SPAN, 36" RISE ROADWAY PIPE END TREATMENT, CLASS 1 (DOUBLE LINE)	2	EA	
619B299	44" SPAN, 27" RISE ROADWAY PIPE END TREATMENT, CLASS 1 (TRIPLE LINE)	1	EA	
620A000	MINOR STRUCTURE CONCRETE	219	CU YD	
631C000	STEEL BEAM GUARDRAIL, CLASS A, TYPE 1 RESET	140	LF	
631C003	GUARDRAIL END ANCHOR, TYPE 13 RESET	4	EA	
650A000	TOPSOIL	490	CU YD	
652A100	SEEDING	2.1	ACRE	=
654A001	SOLID SODDING (BERMUDA)	388	SQ YD	
665J002	SILT FENCE	4045	LF	
665L000	FLOATING BASIN BOOM	56	LF	
665O001	SILT FENCE REMOVAL	4045	LF	
665Q002	WATTLE	2100	LF	-
680A001	GEOMETRIC CONTROLS	1	LS	
701B100	ROADWAY TRAFFIC STRIPE SCHEME	1	LS	
742A003	PORTABLE CHANGEABLE MESSAGE SIGN, TYPE 3	4	EA	
740A000	TRAFFIC CONTROL SCHEME	1	LS	

REFERENCE FISCAL SHEET NO
BCP#0218014 2016 2

PROJECT NOTES
200 800
201 801
302 802
303 803
701 900
702 901

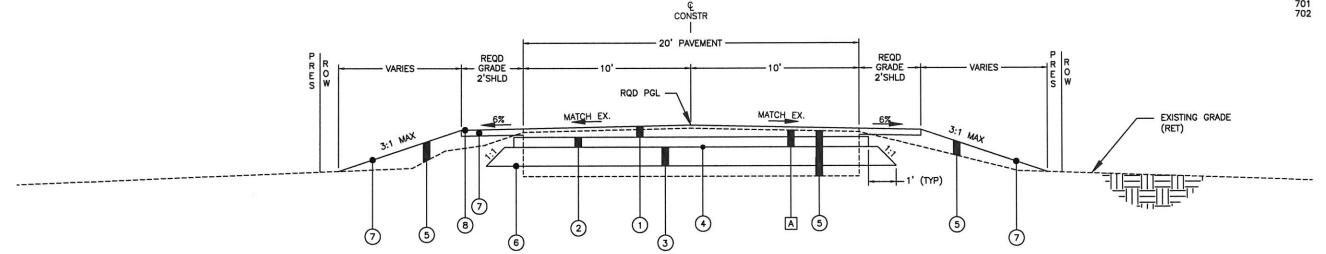

#### TYPICAL SECTION ASPHALT ROADWAY

CR-91	CR-87	STUCKI ROAD	FEELY RD	SOLDER CREEK ROAD	FISH TRAP ROAD	STUCKI ROAD	CR-95	HAMMOCK ROAD
BC300-014	BC300-051	BC300-053	BC300-055	BC300-182	BC300-228	BC300-246	BC300-248	BC300-252
STA 400+7	STA 100+11	STA 1500+12	STA 1000+39	STA 1600+13	STA 1100+4	STA 2100+00	STA 3000+00	STA 1200+5
TO	TO	TO	TO	TO	TO	TO	TO	TO
STA 401+43	STA 101+39	STA 1501+38	STA 1001+35	STA 1601+51	STA 1101+35	STA 2102+18	STA 3001+68	STA 1201+23

#### REQUIRED MATERIALS LEGEND

1 ITEM 424A -340, SUPERPAVE BITUMINOUS CONCRETE WEARING SURFACE LAYER 1/2" MAX. AGGREGATE SIZE MIX, ESAL RANGE A/B, PER TON (220 LBS/SY)

2 ITEM 424B-666, SUPERPAVE BITUMINOUS CONCRETE LOWER BINDER LAYER
1" MAX. AGGREGATE SIZE MIX, ESAL RANGE A/B, PER TON (300 LBS/SY)

(2A) ITEM 408A-051 PLANING EXISTING PAVEMENT (APPROXIMATELY 0.00" THRU 2.10" THICK)

3 ITEM 301A-012, CRUSHED AGGREGATE BASE COURSE, TYPE B, PLANT MIXED, 6" COMPACTED THICKNESS

4 ITEM 401A-000 BITUMINOUS TREATMENT A

(5) ITEM 210A-000, UNCLASSIFIED EXCAVATION AND/OR ITEM 210D-022, BORROW EXCAVATION (LOOSE TRUCKBED MEASUREMENT) (A-2-4(0) OR


(6) ITEM 230A-000 ROADBED PROCESSING

7) ITEM 650A-000, TOPSOIL (APPROX. 4" THICK)


(8) ITEM 654A-001, SOLID SODDING (BERMUDA)

#### EXISTING MATERIALS LEGEND

A IN PLACE BITUMINOUS PAVEMENT (APPROX 2.25" - 5.50") (PLANE AND OVERLAY)

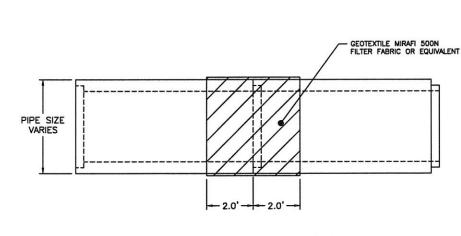

\*\*\* TACK COAT, SAWCUT AND PLANING SHALL BE A SUBSIDIARY OBLIGATION OF ITEM 424A-340

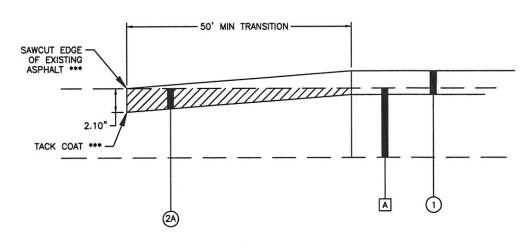

DETAIL OF TYPICAL PAVEMENT TRANSITION

DETAIL OF TYPICAL RCP JOINT

PLAN SUBMITTAL BALDWIN COUNTY
HIGHWAY DEPARTMENT


BALDWIN COUNTY
HIGHWAY DEPARTMENT

NTS

SHEET TITLE ROUTE
TYPICAL SECTION

SHEET NO REFERENCE PROJECT NO FISCAL YEAR 2016 2A BCP#0218014

PROJECT NOTES
200 800
201 801
302 802
303 803
701 900
702 901

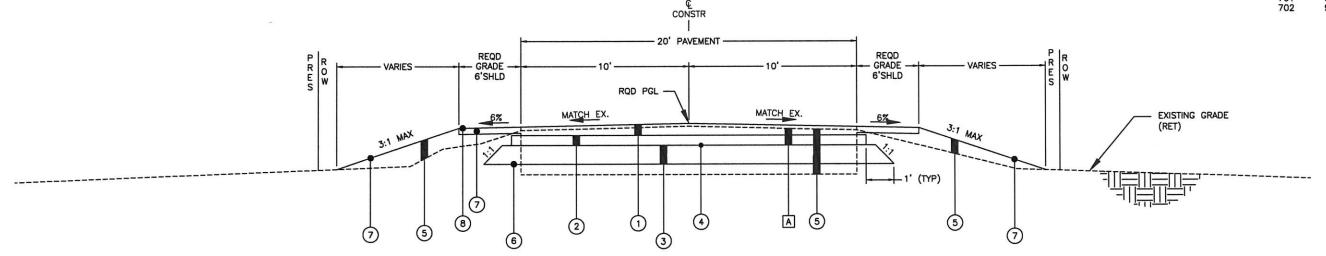

TYPICAL SECTION ASPHALT ROADWAY

CR-97 BC300-024

CR-95 BC300-112

CR-95 BC300-118

**CR-87** BC300-185

CR-91 BC300-231

STA 600+9 TO STA 601+41

STA 700+11 TO STA 701+39

STA 800+8 TO STA 801+42

STA 300+14 TO STA 301+36


STA 500+4 TO STA 501+46

#### REQUIRED MATERIALS LEGEND


- (1) ITEM 424A -340, SUPERPAVE BITUMINOUS CONCRETE WEARING SURFACE LAYER 1/2" MAX. AGGREGATE SIZE MIX, ESAL RANGE A/B, PER TON (220 LBS/SY)
- (2) ITEM 424B-666, SUPERPAVE BITUMINOUS CONCRETE LOWER BINDER LAYER 1" MAX. AGGREGATE SIZE MIX, ESAL RANGE A/B, PER TON (300 LBS/SY)
- (2A) ITEM 408A-051 PLANING EXISTING PAVEMENT (APPROXIMATELY 0.00" THRU 2.10" THICK)
- 3 ITEM 301A-012, CRUSHED AGGREGATE BASE COURSE, TYPE B, PLANT MIXED, 6" COMPACTED THICKNESS
- 4 ITEM 401A-000 BITUMINOUS TREATMENT A
- 5 ITEM 210A-000, UNCLASSIFIED EXCAVATION AND/OR BORROW EXCAVATION (LOOSE TRUCKBED MEASUREMENT) (A-2-4(0) OR ITEM 210D-022, A-4(0))
- (6) ITEM 230A-000 ROADBED PROCESSING
- TOPSOIL (APPROX. 4" THICK) ITEM 650A-000,
- (8) ITEM 654A-001, SOLID SODDING (BERMUDA)

#### **EXISTING MATERIALS LEGEND**

IN PLACE BITUMINOUS PAVEMENT (APPROX 2.25" - 5.50") (PLANE AND OVERLAY)

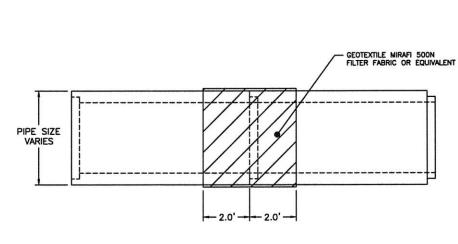

\*\*\* TACK COAT, SAWCUT AND PLANING SHALL BE A SUBSIDIARY OBLIGATION OF ITEM 424A-340

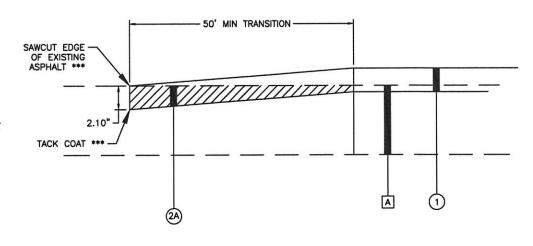

DETAIL OF TYPICAL PAVEMENT TRANSITION

DETAIL OF TYPICAL RCP JOINT

PLAN SUBMITTAL **BALDWIN COUNTY** HIGHWAY DEPARTMENT DATE: 08/06/2015


NTS

SHEET TITLE ROUTE

TYPICAL SECTION

REFERENCE FISCAL SHEET PROJECT NO YEAR NO BCP#0218014 2016 2B

PROJECT NOTES
200 800
201 801
302 802
303 803
701 900
702 901

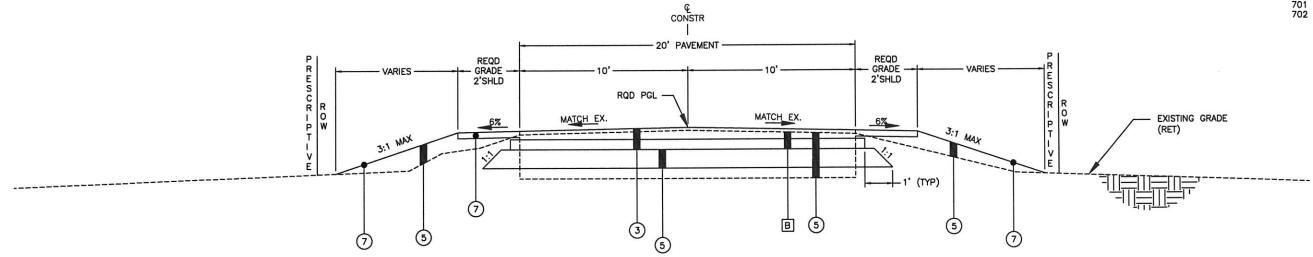

### TYPICAL SECTION DIRT & GRAVEL ROADWAY

WOLF FIELD ROAD BC300-198 MAIDMONT LN BC300-224

STA 1700+9 TO STA 1701+42

STA 1800+1 TO STA 1801+41


#### REQUIRED MATERIALS LEGEND

1	ITEM 424A-340,	SUPERPAVE BITUMINOUS CONCRETE WEARING SURFACE LAYER	

- (2) ITEM 424B-666, SUPERPAVE BITUMINOUS CONCRETE LOWER BINDER LAYER
  1" MAX. AGGREGATE SIZE MIX, ESAL RANGE A/B, PER TON (300 LBS/SY)
- (2A) ITEM 408A-051 PLANING EXISTING PAVEMENT (APPROXIMATELY 0.00" THRU 2.10" THICK)
- 3 ITEM 301A-012, CRUSHED AGGREGATE BASE COURSE, TYPE B, PLANT MIXED, 6" COMPACTED THICKNESS
- 4 ITEM 401A-000 BITUMINOUS TREATMENT A
- 5 ITEM 210A-000, UNCLASSIFIED EXCAVATION AND/OR
  - ITEM 210D-022, BORROW EXCAVATION (LOOSE TRUCKBED MEASUREMENT) (A-2-4(0) OR A-4(0))
- 6 ITEM 230A-000 ROADBED PROCESSING
- 7 ITEM 650A-000, TOPSOIL (APPROX. 4" THICK)
- 8 ITEM 654A-001, SOLID SODDING (BERMUDA)

#### EXISTING MATERIALS LEGEND

- A IN PLACE BITUMINOUS PAVEMENT (APPROX 2.25" 5.50") (PLANE AND OVERLAY)
- B IN PLACE GRAVEL (APPROX 2.25"-5.50") (REMOVE)

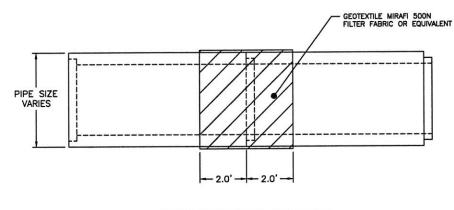


DETAIL	OF	TYF	PICAL	RCP	<b>JOIN</b>	I

	PLAN SURMITTAL	BALDWIN COUNTY	NITO	SHEET TITLE	ROUTE
DATE: 08/06/2015	TEXT SOSMITTAL	HIGHWAY DEPARTMENT	I NIS	TYPICAL SECTION	

REFERENCE FISCAL SHEET NO YEAR NO BCP#0218014 2016 2C

PROJECT NOTES
200 800
201 801
302 802
303 803
701 900
702 901

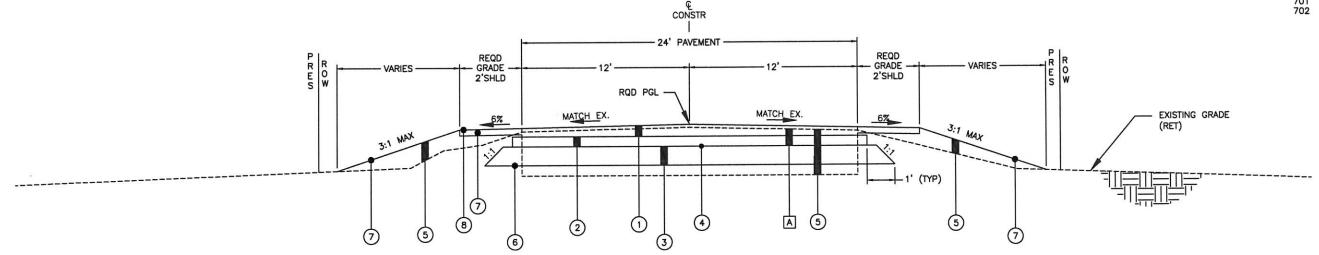

## TYPICAL SECTION ASPHALT ROADWAY

MIFLIN ROAD BC300-283


STA 2300+00 TO STA 2302+35

#### REQUIRED MATERIALS LEGEND


- 1 ITEM 424A -340, SUPERPAVE BITUMINOUS CONCRETE WEARING SURFACE LAYER 1/2" MAX. AGGREGATE SIZE MIX, ESAL RANGE A/B, PER TON (220 LBS/SY)
- (2) ITEM 424B-666, SUPERPAVE BITUMINOUS CONCRETE LOWER BINDER LAYER
  1" MAX. AGGREGATE SIZE MIX, ESAL RANGE A/B, PER TON (300 LBS/SY)
- (2A) ITEM 408A-051 PLANING EXISTING PAVEMENT (APPROXIMATELY 0.00" THRU 2.10" THICK)
- 3 ITEM 301A-012, CRUSHED AGGREGATE BASE COURSE, TYPE B, PLANT MIXED, 6" COMPACTED THICKNESS
- 4 ITEM 401A-000 BITUMINOUS TREATMENT A
- (5) ITEM 210A-000, UNCLASSIFIED EXCAVATION AND/OR ITEM 210D-022, BORROW EXCAVATION (LOOSE TRUCKBED MEASUREMENT) (A-2-4(0) OR
- 6 ITEM 230A-000 ROADBED PROCESSING
- 7 ITEM 650A-000, TOPSOIL (APPROX. 4" THICK)
- (8) ITEM 654A-001, SOLID SODDING (BERMUDA)

#### EXISTING MATERIALS LEGEND

IN PLACE BITUMINOUS PAVEMENT (APPROX 2.25" - 5.50") (PLANE AND OVERLAY)

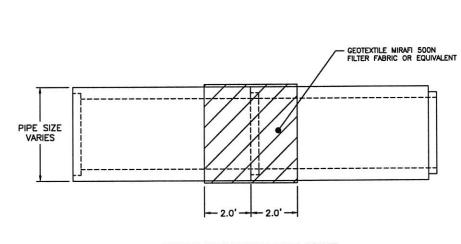

\*\*\* TACK COAT, SAWCUT AND PLANING SHALL BE A SUBSIDIARY OBLIGATION OF ITEM 424A-340

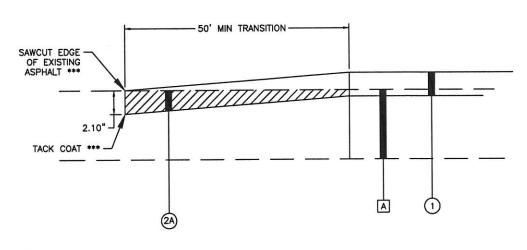


DETAIL OF TYPICAL PAVEMENT TRANSITION

## DETAIL OF TYPICAL RCP JOINT

	PLAN SUBMITTAL	BALDWIN COUNTY	80 001-100	SHEET TITLE	ROUTE
	TEAN SOUNTIAL	HIGHWAY DEPARTMENT	NTS	TYPICAL SECTION	MIFLIN RD
DATE: 08/06/2015		IIIdiiwai bli akimilai		1	1000 -000 000

REFERENCE FISCAL SHEET NO YEAR NO BCP#0218014 2016 2D

PROJECT NOTES
200 800
201 801
302 802
303 803
701 900
702 901

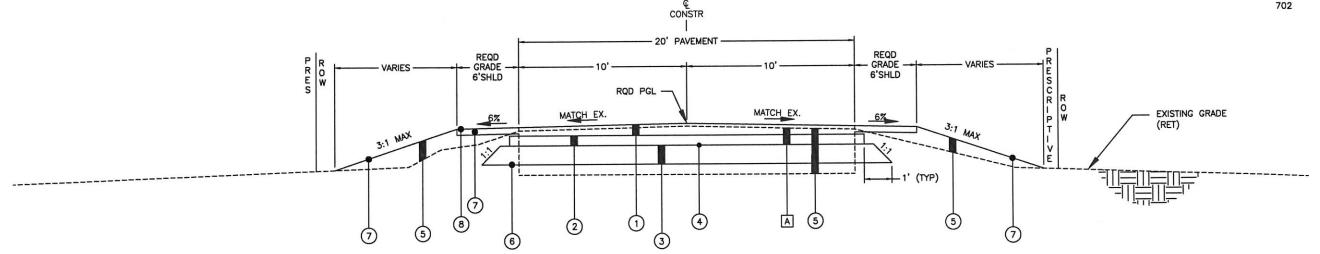

## TYPICAL SECTION ASPHALT ROADWAY

CR-87 BC300-052

STA 200+10 TO STA 201+40

#### REQUIRED MATERIALS LEGEND

1 ITEM 424A -340, SUPERPAVE BITUMINOUS CONCRETE WEARING SURFACE LAYER 1/2" MAX. AGGREGATE SIZE MIX, ESAL RANGE A/B, PER TON (220 LBS/SY)

2 ITEM 424B-666, SUPERPAVE BITUMINOUS CONCRETE LOWER BINDER LAYER
1" MAX. AGGREGATE SIZE MIX, ESAL RANGE A/B, PER TON (300 LBS/SY)

(2A) ITEM 408A-051 PLANING EXISTING PAVEMENT (APPROXIMATELY 0.00" THRU 2.10" THICK)

3 ITEM 301A-012, CRUSHED AGGREGATE BASE COURSE, TYPE B, PLANT MIXED, 6" COMPACTED THICKNESS

4 ITEM 401A-000 BITUMINOUS TREATMENT A

TITEM 210A-000, UNCLASSIFIED EXCAVATION
AND/OR
ITEM 210D-022, BORROW EXCAVATION (LOOSE TRUCKBED MEASUREMENT) (A-2-4(0) OR


(6) ITEM 230A-000 ROADBED PROCESSING

7) ITEM 650A-000, TOPSOIL (APPROX. 4" THICK)

(8) ITEM 654A-001, SOLID SODDING (BERMUDA)

#### EXISTING MATERIALS LEGEND

A IN PLACE BITUMINOUS PAVEMENT (APPROX 2.25" - 5.50") (PLANE AND OVERLAY)

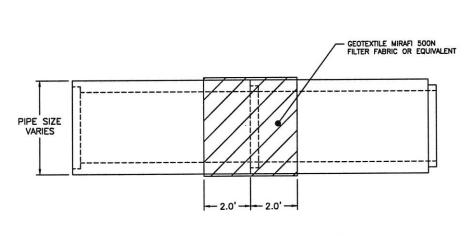

#### DETAIL OF TYPICAL RCP JOINT

PLAN SUBMITTAL

BALDWIN COUNTY
HIGHWAY DEPARTMENT

DETAIL OF TYPICAL PAVEMENT TRANSITION

-50' MIN TRANSITION -

SHEET TITLE ROUTE
TYPICAL SECTION CR-87

À

## DATE: 08/06/2015

6/2015

NTS

\*\*\* TACK COAT, SAWCUT AND PLANING SHALL BE A SUBSIDIARY OBLIGATION OF ITEM 424A-340

SAWCUT EDGE -


OF EXISTING

2.10"

TACK COAT \*\*\* --

REFERENCE FISCAL SHEET PROJECT NO YEAR NO BCP#0218014 2016 2E

PROJECT NOTES
200 800
201 801
302 802
303 803
701 900
702 901

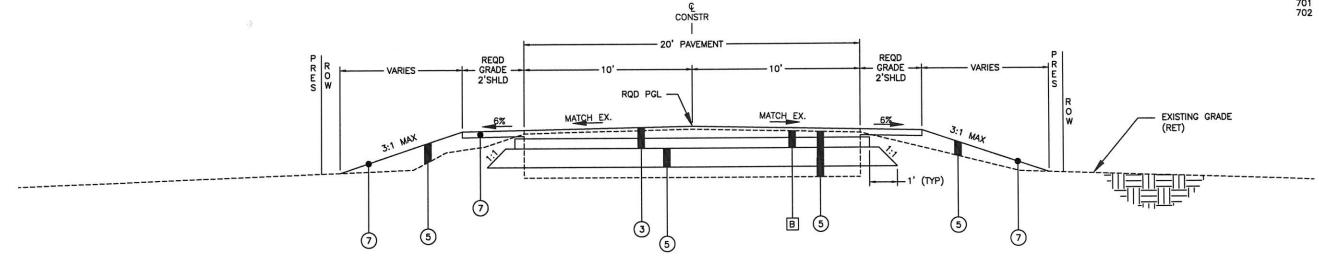

## TYPICAL SECTION DIRT & GRAVEL ROADWAY

MIFLIN CREEK RD BC300-043

STA 2000+00 TO STA 2002+30


#### REQUIRED MATERIALS LEGEND

1) ITEM 424A-340,	SUPERPAVE BITUMINOUS CONCRETE WEARING SURFACE LAYER
	1/2" MAX. AGGREGATE SIZE MIX, ESAL RANGE A/B, PER TON (220 LBS/SY)

- 2 ITEM 424B-666, SUPERPAVE BITUMINOUS CONCRETE LOWER BINDER LAYER
  1" MAX. AGGREGATE SIZE MIX, ESAL RANGE A/B, PER TON (300 LBS/SY)
- (2A) ITEM 408A-051 PLANING EXISTING PAVEMENT (APPROXIMATELY 0.00" THRU 2.10" THICK)
- 3 ITEM 301A-012, CRUSHED AGGREGATE BASE COURSE, TYPE B, PLANT MIXED, 6" COMPACTED THICKNESS
- 4 ITEM 401A-000 BITUMINOUS TREATMENT A
- (5) ITEM 210A-000, AND/OR ITEM 210D-022, BORROW EXCAVATION (LOOSE TRUCKBED MEASUREMENT) (A-2-4(0) OR A-4(0))
- 6 ITEM 230A-000 ROADBED PROCESSING
- 7 ITEM 650A-000, TOPSOIL (APPROX. 4" THICK)
- (8) ITEM 654A-001, SOLID SODDING (BERMUDA)

#### EXISTING MATERIALS LEGEND

- IN PLACE BITUMINOUS PAVEMENT (APPROX 2.25" 5.50") (PLANE AND OVERLAY)
- B IN PLACE GRAVEL (APPROX 2.25"-5.50") (REMOVE)

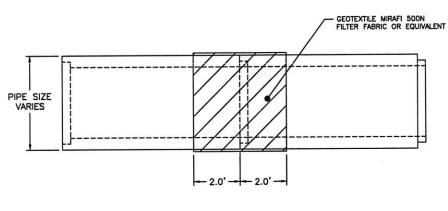


DETAIL OF TYPICAL RCP JOINT

	PLAN SURMITTAL	1	BALDWIN COUNTY		SHEET TITLE	ROUTE
	LAR SODIVITTAL	《樂》	HIGHWAY DEPARTMENT	NTS	TYPICAL SECTION	
DATE: 08/06/2015		The state of the s	HIGHWAI DEPARTMENT		THE SECTION	

REFERENCE PROJECT NO FISCAL YEAR NO 2F BCP#0218014 2016

PROJECT NOTES
200 800
201 801
302 802
303 803
701 900
702 901

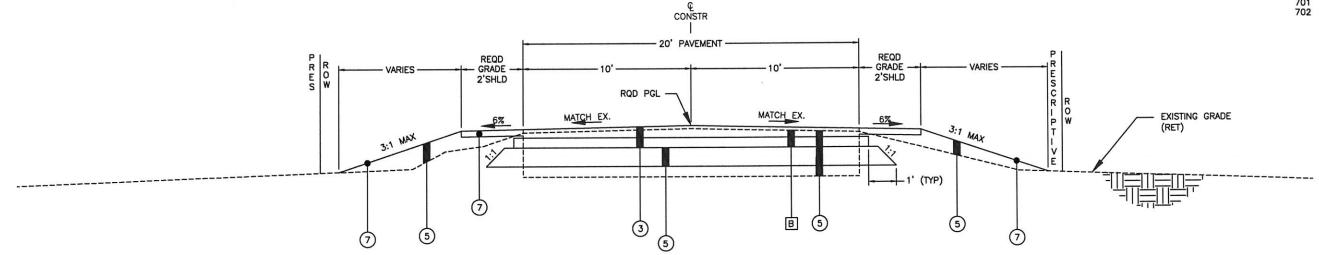

## **TYPICAL SECTION DIRT & GRAVEL ROADWAY**

CR-26 BC300-121

STA 2500+10 TO STA 2502+31


#### REQUIRED MATERIALS LEGEND

(1) II	EM 424A-340,	SUPERPAVE BITUMINOUS CONCRETE WEARING SURFACE LAYER	
$\circ$		1/2" MAX. AGGREGATE SIZE MIX, ESAL RANGE A/B, PER TON (220 LBS/SY)	

- 2 ITEM 424B-666, SUPERPAVE BITUMINOUS CONCRETE LOWER BINDER LAYER 1" MAX. AGGREGATE SIZE MIX, ESAL RANGE A/B, PER TON (300 LBS/SY)
- (2A) ITEM 408A-051 PLANING EXISTING PAVEMENT (APPROXIMATELY 0.00" THRU 2.10" THICK)
- 3 ITEM 301A-012, CRUSHED AGGREGATE BASE COURSE, TYPE B, PLANT MIXED, 6" COMPACTED THICKNESS
- 4) ITEM 401A-000 BITUMINOUS TREATMENT A
- 5 ITEM 210A-000, UNCLASSIFIED EXCAVATION AND/OR BORROW EXCAVATION (LOOSE TRUCKBED MEASUREMENT) (A-2-4(0) OR ITEM 210D-022,
- 6 ITEM 230A-000 ROADBED PROCESSING
- 7 ITEM 650A-000, TOPSOIL (APPROX. 4" THICK)
- (8) ITEM 654A-001, SOLID SODDING (BERMUDA)


#### EXISTING MATERIALS LEGEND

- IN PLACE BITUMINOUS PAVEMENT (APPROX 2.25" 5.50") (PLANE AND OVERLAY)
- IN PLACE GRAVEL (APPROX 2.25"-5.50") (REMOVE)

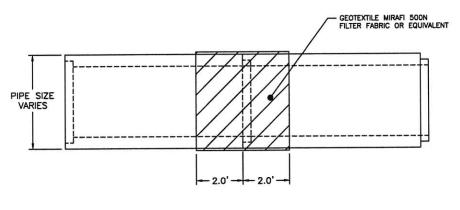

DETAIL OF TYPICAL RCP JOINT

	PLAN SUBMITTAL	圖	BALDWIN COUNTY
DATE:	08/06/2015	THE REAL PROPERTY.	HIGHWAY DEPARTME

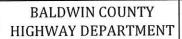

	SHEET TITLE	ROUTE
NTS	TYPICAL SECTION	

# PROJECT NOTES

REFERENCE	FISCAL	SHEET
PROJECT NO	YEAR	NO
BCP#0218014	2016	

NOTE NO.		NOTE NO.	
200	PLAN SHEET SHALL BE USED IN CONJUNCTION WITH TYPICAL SECTIONS TO ENSURE PROPER PAVEMENT WIDTHS.	701	CONTRACTOR SHALL INSTALL REQUIRED PAVEMENT STRIPING TO MATCH THE EXISTING STRIPING APPARENT BEFORE PAVEMENT REMOVAL. PAYMENT SHALL BE MADE USING LUMP SUM PAY ITEMS FOR PAINT STRIPING, PAY ITEM 701B-100.
201	WORK LIMITS SHALL NOT EXTEND PAST THE EXISTING RIGHT OF WAY.	702	TRAFFIC CONTROL SCHEMES ARE "FOR REFERENCE ONLY".
202	FRONT SLOPES SHALL BE GRADED TO 3:1 (HORIZONTAL:VERTICAL) MAXIMUM WITH THE CLEAR ZONE, WITH 2:1		TRAFFIC CONTROL SCHEME SHALL COMPLY WITH MUTCD GUIDELINES.
	(HORIZONTAL: VERTICAL) MAXIMUM SLOPE OUTSIDE OF THE CLEAR ZONE ONLY IN AREAS TO MAINTAIN WORK LIMITS WITHIN THE EXISTING RIGHT OF WAY.	703	CONTRACTOR WILL BEGIN WORK ON SITES BC300-014, BC300-231 & BC300-024 FIRST TO ENSURE SITES ARE COMPLETED AS EXPEDITIOUSLY AS POSSIBLE FOLLOWING THE NOTICE TO PROCEED.
301	REMOVAL OF ROADWAY MATERIALS INCLUDING PAVEMENT AND BASE MATERIALS SHALL BE PAID FOR UNDER PAY ITEM 210A000 UNCLASSIFIED EXCAVATION.	704	THE NUMBER OF DAYS FOR ALL PROPOSED ROAD CLOSURES MUST BE APPROVED BY BALDWIN COUNTY PRIOR TO CONSTRUCTION
302	CLEARING & GRUBBING IS A SUBSIDIARY TO UNCLASSIFIED EXCAVATION PAY ITEM 210A000.		START FOR EACH INDIVIDUAL SITE.
303	THIS PROJECT REQUIRES THAT SAW CUTTING OF EXISTING CONCRETE AND/OR ASPHALT DRIVEWAYS FOLLOW SMOOTH LINES. CURVED AREAS SHALL BE REPLACED BY SEGMENTS OF STRAIGHT LINES. FOLLOWING THE COMPLETION OF THE SAW CUT IN AM AREA OF WORK. THE CONTRACTOR SHALL CAREFULLY REMOVE THE CONCRETE OR ASPHALT PAVEMENT AND OTHER MATERIAL REQUIRED TO PREPARE THE SUBGRADE. THE CONTRACTOR IS TO MAINTAIN AND PROTECT THE SAW CUT LINE WHILE DOING OTHER WORK IN THE VICINITY OF THE SAW CUT SO THAT A NEAT, SMOOTH JOINT SHALL BE SUBSIDIARY OBLIGATION OF PAY ITEM NO. 424A-340.	800	IT SHALL BE THE CONTRACTOR'S RESPONSIBILITY TO CONTACT THE VARIOUS UTILITY OWNERS AND DETERMINE THE EXACT LOCATION OF ALL EXISTING UTILITIES ON THIS PROJECT WHETHER SHOWN ON THE PLANS OR NOT. UTILITY LOCATIONS ARE APPROXIMATE AND CARE SHOULD BE TAKEN WHEN WORKING IN THESE AREAS. IN THE EVENT OF ANY DAMAGE TO IN-PLACE UTILITIES, THEY SHALL BE REPAIRED OR REPLACED TO THE SATISFACTION OF THE ENGINEER AND THE UTILITY OWNER AT THE CONTRACTORS'S EXPENSE. THE LOCATION OF ANY REQUIRED GUARDRAIL, SIGNS, FOOTINGS OF ANY NATURE AND/OR ELECTRICAL/COMMUNICATIONS CONDUITS MAY BE ADJUSTED AS DIRECTED BY THE ENGINEER TO PREVENT ANY CONFLICTS WITH
304	AN ADDITIONAL 25 TONS PER SITE OF AGGREGATE SURFACING ALDOT NO. 57 STONE HAS BEEN SETUP TO BE USED AS DIRECTED BY THE PROJECT ENGINEER.	801	THESE UTILITIES.  IF UTILITY CONFLICTS ARE ENCOUNTERED, EXISTING UTILITIES
305	POLYETHYLENE SHALL BE USED IN AREAS AS DESIGNATED BY THE ENGINEER FOR EROSION PROTECTION PAID FOR AS SUBSIDIARY TO PAY ITEM NO. 6650-001.		ARE TO BE ADJUSTED AS DIRECTED BY THE ENGINEER OR UTILITY OWNER. THE CONTRACTOR SHALL COORDINATE A PLAN OF UTILITY ADJUSTMENT WITH THE UTILITY COMPANIES AT HIS OWN EXPENSE.
306 400	MULCHING IS A SUBSIDIARY OF SEEDING PAY ITEM 652A100.  ANY IN-PLACE PAVED DITCHES, RIP RAPPED SLOPED, AND	802	CONTRACTOR IS REQUIRED TO CONTACT BALDWIN COUNTY HIGHWAY DEPARTMENT 72 HOURS PRIOR TO ANY ROAD CLOSURES.
400	AGGREGATED SURFACED AREAS THAT ARE TO BE RETAINED AND ARE DAMAGED BY THE CONTRACTOR SHALL BE REPLACED IN KIND AT THE CONTRACTOR'S EXPENSE. GROUND COVER QUANTITIES (INCLUDING SOD, SEEDING, RIP RAP, AGGREGATE SURFACING AND	803	IT SHALL BE THE RESPONSIBILITY OF THE CONTRACTOR TO PROPERLY STAGE WORK ON MULTIPLE SITES SO THAT NO CONFLICTS IN TRAFFIC FLOW SHALL ARISE.
	SOIL STABILIZATION) MAY BE PLACED AT ANY TIME DURING CONSTRUCTION OR AS DIRECTED BY THE ENGINEER. THE CONTRACTOR SHALL BE RESPONSIBLE FOR MAINTAINING THESE AREAS THROUGHOUT THE COMPLETIONS OF THE PROJECT. NO ADDITIONAL PAYMENT WILL BE MADE FOR THE REPAIR OR MAINTENANCE OF THESE AREAS.	900	THE PROJECT IS UNDER A NATIONWIDE 3 PERMIT FOR EMERGENCY REPAIR WORK. A COPY CAN BE PICKED UP AT BALDWIN COUNTY HIGHWAY DEPARTMENT OFFICE. LIMITS OF CONSTRUCTION SHALL NOT BE BEYOND THOSE NOTED IN THE PLANS AND CARE SHALL BE TAKEN TO MINIMIZE DISTURBANCE TO EXISTING VEGETATION.
401	CONTRACTOR SHALL REMOVE PIPE UNDER PAY ITEM 206D000 AND SHALL DISPOSE OF PIPE AT THE NEAREST COUNTY BARN AREA 200 BARN (SILVERHILL) AREA 300 BARN (FOLEY) 22220 WE3ST BLVD. 20764 COUNTY ROAD 24	901	FUEL TANKS SHALL NOT BE STORED ON THE RIGHT OF WAY OVERNIGHT. VEHICLES TRANSPORTING FUEL, CHEMICALS, FERTILIZERS, ETC. ONTO THE RIGHT OF WAY SHALL NOT BE LEFT UNATTENDED.
	SILVERHILL, AL 36576 FOLEY, AL 36535 251-972-8509 251-972-8530	902	THE CONTRACTOR SHALL HAVE A COPY OF THE FOLLOWING PUBLICATIONS FOR REFERENCE
500	THE CONTRACTOR SHALL BE FULLY RESPONSIBLE FOR THE PROTECTION OF WATER QUALITY AT ALL TIMES DURING FILL	۸.	STATE OF ALABAMA HIGHWAY DEPARTMENT, STANDARD SPECIFICATIONS FOR HIGHWAY CONSTRUCTION, 2012 EDITION
	OPERATIONS AND CULVERT CONSTRUCTION WITHIN THE STREAM, UNLESS SHOWN OTHERWISE. THE CONTRACTOR SHALL DESIGN AND	В.	MANUAL FOR UNIFORM TRAFFIC CONTROL AND DEVICES, SECTION 6, 2009 EDITION
	IMPLEMENT NECESSARY CONTROLS AT THE SITES OF THE CULVERT, INCLUDING CONSTRUCTION OF AND PROTECTION OF WATER QUALITY AT DIVERSION CHANNELS AND COFFERDAMS. DETAILS OF SUCH PROVISIONS SHALL BE INCLUDED IN THE STORMWATER MANAGEMENT PLAN SUBMITTED. THE COST REQUIRED FOR THESE PROVISIONS SHALL BE INCLUDED IN PAY ITEM 6650-000.	c.	ALABAMA HANDBOOK FOR EROSION CONTROL, SEDIMENT CONTROL, AND STORMWATER MANAGEMENT ON CONSTRUCTION SITES AND URBAN AREAS, VOL 1 & 2 CURRENT EDITION

# SUMMARY OF QUANTITIES

REFERENCE PROJECT NO	FISCAL	SHEET	
BCP#0218014	2016	3	

210D022 BORROW EXCAVA A-4(0) 214B001 FOUNDATION BAG 215B000 COFFERDAMS OF 230A000 ROADBED PROCE 301A012 CRUSHED AGGRE COMPACTED THIC 401A000 BITUMINOUS TRE 424A340 SUPERPAVE BITL AGGREGATE SIZI 430B003 AGGREGATE SUF 502A000 STEEL REINFORC 530A003 30" ROADWAY PIF 530A004 36" ROADWAY PIF 530A006 48" ROADWAY PIF 530A006 48" ROADWAY PIF 530A007 54" ROADWAY PIF 530B003 36" SPAN, 23" RIS 530B004 44" SPAN, 27" RIS 600A000 MOBILIZATION 610C001 LOOSE RIPRAP, C 610D003 FILTER BLANKET, 619A004 30" ROADWAY PIF 619A204 36" ROADWAY PIF 619A207 48" ROADWAY PIF 619A209 60" ROADWAY PIF 619B209 48" ROADWAY PIF 619B209 54" ROADWAY PIF 619B201 59" SPAN, 36" RIS 619B211 59" SPAN, 36" RIS 619B211 59" SPAN, 36" RIS 619B213 54" SPAN, 27" RIS 619B213 44" SPAN, 27" RIS 619B214 59" SPAN, 27" RIS 619B215 59" SPAN, 36" RIS 619B216 54" SPAN, 27" RIS 619B217 59" SPAN, 27" RIS 619B218 44" SPAN, 27" RIS 619B219 59" SPAN, 27" RIS 619B218 54" SPAN, 27" RIS 619B219 59" SPAN, 27" RIS 619B210 50" SPEEL BEAM GUA 631E003 GUARDRAIL END 650A000 TOPSOIL 652A100 SEEDING 654A001 SOLID SODDING 6	PIPE IEADWALLS	SQ YD LF EA	395 970	28				10				
206D000         REMOVING PIPE           206E000         REMOVING HEAD           210A000         UNCLASSIFIED EX           210A000         MUCK EXCAVATION           210D022         BORROW EXCAVA           210D022         BORROW EXCAVA           214B001         FOUNDATION BAG           215B000         COFFERDAMS OF           230A000         ROADBED PROCE           301A012         CRUSHED AGGRE COMPACTED THIC           401A000         BITUMINOUS TRE           424B666         SUPERPAVE BITL AGGREGATE SIZE           430B003         AGGREGATE SUF           502A000         STEEL REINFORD           530A003         30" ROADWAY PIF           530A004         36" ROADWAY PIF           530A005         54" ROADWAY PIF           530B006         48" ROADWAY PIF           530B007         54" ROADWAY PIF           530B008         73" SPAN, 23" RIS           530B009         73" SPAN, 45" RIS           600A000         MOBILIZATION           610C001         LOOSE RIPRAP, C           619A204         36" ROADWAY PIF           619A205         48" ROADWAY PIF           619A206         48" ROADWAY PIF           61	ED EXCAVATION VATION & REMOVAL		970			1	4	40		23		401
210A000 UNCLASSIFIED EX 210C000 MUCK EXCAVATION 210D022 BORROW EXCAVA A-4(0) 214B001 FOUNDATION BAGE 230A000 ROADBED PROCES COMPACTED THIN 401A000 BITUMINOUS TREST SUPERPAVE BITLAGGREGATE SIZE ASSESSED	ED EXCAVATION VATION & REMOVAL	EA	1 3/0	37	38	35	37	111	39	41	40	300
210C000 MUCK EXCAVATION 210D022 BORROW EXCAV A-4(0) 214B001 FOUNDATION BAG 215B000 COFFERDAMS OF 230A000 ROADBED PROCE 301A012 CRUSHED AGGRE COMPACTED THIC 401A000 BITUMINOUS TRE SUPERPAVE BITL AGGREGATE SIZE 430B003 AGGREGATE SUF 502A000 STEEL REINFORD 530A003 30" ROADWAY PIF 530A004 36" ROADWAY PIF 530A006 48" ROADWAY PIF 530A006 48" ROADWAY PIF 530A007 54" ROADWAY PIF 530B003 36" SPAN, 23" RIS 530B004 44" SPAN, 27" RIS 600A000 MOBILIZATION 610C001 LOOSE RIPRAP, C 619A204 36" ROADWAY PIF 619A204 36" ROADWAY PIF 619A204 36" ROADWAY PIF 619A205 48" ROADWAY PIF 619A206 48" ROADWAY PIF 619A207 48" ROADWAY PIF 619A208 54" ROADWAY PIF 619A209 60" ROADWAY PIF 619B209 44" SPAN, 27" RIS 619B201 73" SPAN, 45" RIS 619B201 44" SPAN, 27" RIS 619B203 73" SPAN, 45" RIS 619B203 73" SPAN, 45" RIS 619B209 44" SPAN, 27" RIS 619B218 44" SPAN, 27" RIS 619B219 44" SPAN, 27" RIS 619B218 44" SPAN, 27" RIS 619B219 59" SPAN, 36" RIS 619B210 STEEL BEAM GUA 631E003 GUARDRAIL END 654A001 SOLID SODDING 6	VATION & REMOVAL		10		2		2	2	2			
210D022 BORROW EXCAVA A-4(0) 214B001 FOUNDATION BAG 215B000 COFFERDAMS OF 230A000 ROADBED PROCE 301A012 CRUSHED AGGRE COMPACTED THIC 401A000 BITUMINOUS TRE 424A340 SUPERPAVE BITL AGGREGATE SIZI 430B003 AGGREGATE SUF 502A000 STEEL REINFORC 530A003 30" ROADWAY PIF 530A004 36" ROADWAY PIF 530A006 48" ROADWAY PIF 530A006 48" ROADWAY PIF 530A007 54" ROADWAY PIF 530B003 36" SPAN, 23" RIS 530B004 44" SPAN, 27" RIS 600A000 MOBILIZATION 610C001 LOOSE RIPRAP, C 610D003 FILTER BLANKET, 619A004 30" ROADWAY PIF 619A204 36" ROADWAY PIF 619A207 48" ROADWAY PIF 619A209 60" ROADWAY PIF 619B209 48" ROADWAY PIF 619B209 54" ROADWAY PIF 619B201 59" SPAN, 36" RIS 619B211 59" SPAN, 36" RIS 619B211 59" SPAN, 36" RIS 619B213 54" SPAN, 27" RIS 619B213 44" SPAN, 27" RIS 619B214 59" SPAN, 27" RIS 619B215 59" SPAN, 36" RIS 619B216 54" SPAN, 27" RIS 619B217 59" SPAN, 27" RIS 619B218 44" SPAN, 27" RIS 619B219 59" SPAN, 27" RIS 619B218 54" SPAN, 27" RIS 619B219 59" SPAN, 27" RIS 619B210 50" SPEEL BEAM GUA 631E003 GUARDRAIL END 650A000 TOPSOIL 652A100 SEEDING 654A001 SOLID SODDING 6		CU YD	6190	380	300	390	210	560	300	260	250	301, 302
214B001 FOUNDATION BAG 215B000 COFFERDAMS OF 230A000 ROADBED PROCE 301A012 CRUSHED AGGRE COMPACTED THIC 401A000 BITUMINOUS TRE 424A340 SUPERPAVE BITL AGGREGATE SIZE 430B003 AGGREGATE SUF 502A000 STEEL REINFORD 530A003 30" ROADWAY PIF 530A004 36" ROADWAY PIF 530A006 48" ROADWAY PIF 530A006 48" ROADWAY PIF 530A007 54" ROADWAY PIF 530B003 36" SPAN, 23" RIS 530B004 44" SPAN, 27" RIS 600A000 MOBILIZATION 610C001 LOOSE RIPRAP, C 610PA03 FILTER BLANKET, 619A004 30" ROADWAY PIF 619A204 36" ROADWAY PIF 619A207 48" ROADWAY PIF 619A207 48" ROADWAY PIF 619A208 54" ROADWAY PIF 619A209 60" ROADWAY PIF 619B201 48" ROADWAY PIF 619B203 73" SPAN, 45" RIS 619B271 59" SPAN, 36" RIS 619B271 59" SPAN, 36" RIS 619B299 44" SPAN, 27" RIS 619B299 44" SPAN, 27" RIS 619B218 44" SPAN, 27" RIS 619B219 59" SPAN, 36" RIS 619B210 STEEL BEAM GUA 631E003 GUARDRAIL END 654A001 SOLID SODDING 6	CAVATION (LOOSE TRUCKBED MEASUREMENT)(A-2-4(0) OR	CU YD	690		35	35	35	75	35	35	30	
2158000 COFFERDAMS OF 230A000 ROADBED PROCE 301A012 CRUSHED AGGRI COMPACTED THIC 401A000 BITUMINOUS TRE 424A340 SUPERPAVE BITL MAXIMUM AGGRE 424B666 SUPERPAVE BITL AGGREGATE SUF 502A000 STEEL REINFORC 530A003 30" ROADWAY PIF 530A004 36" ROADWAY PIF 530A006 48" ROADWAY PIF 530A006 48" ROADWAY PIF 530A007 54" ROADWAY PIF 530B003 36" SPAN, 23" RIS 530B004 44" SPAN, 27" RIS 530B006 59" SPAN, 36" RIS 530B006 59" SPAN, 45" RIS 600A000 MOBILIZATION 610C001 LOOSE RIPRAP, C 619A204 36" ROADWAY PIF 619A205 48" ROADWAY PIF 619A207 48" ROADWAY PIF 619A207 48" ROADWAY PIF 619A208 54" ROADWAY PIF 619A209 60" ROADWAY PIF 619B210 44" SPAN, 27" RIS 619B271 59" SPAN, 36" RIS 619B271 59" SPAN, 36" RIS 619B271 59" SPAN, 36" RIS 619B299 44" SPAN, 27" RIS 619B218 44" SPAN, 27" RIS 619B218 44" SPAN, 27" RIS 619B219 GUARDRAIL END 650A000 TOPSOIL 652A100 SEEDING 654A001 SOLID SODDING 6	4	CU YD	6190	380	300	390	210	560	300	260	250	
230A000 ROADBED PROCE 301A012 CRUSHED AGGRE COMPACTED THIC 401A000 BITUMINOUS TRE \$UPERPAVE BITL MAXIMUM AGGRE 424B366 SUPERPAVE BITL AGGREGATE SUF 502A000 STEEL REINFORD 530A003 30" ROADWAY PIE 530A004 36" ROADWAY PIE 530A006 48" ROADWAY PIE 530A007 54" ROADWAY PIE 530A008 60" ROADWAY PIE 530B003 36" SPAN, 23" RIS 530B004 44" SPAN, 27" RIS 530B006 59" SPAN, 36" RIS 530B006 59" SPAN, 36" RIS 530B007 FILTER BLANKET, 619A004 30" ROADWAY PIE 619A204 48" ROADWAY PIE 619A207 48" ROADWAY PIE 619A207 48" ROADWAY PIE 619A208 60" ROADWAY PIE 619A209 60" ROADWAY PIE 619A209 60" ROADWAY PIE 619A209 64" ROADWAY PIE 619A209 64" ROADWAY PIE 619A209 64" ROADWAY PIE 619A209 44" SPAN, 27" RIS 619B217 59" SPAN, 36" RIS 619B217 59" SPAN, 36" RIS 619B218 44" SPAN, 27" RIS 619B219 44" SPAN, 27" RIS 619B219 59" SPAN, 36" RIS 619B219 59" SPAN, 36" RIS 619B219 59" SPAN, 36" RIS 619B219 59" SPAN, 27" RIS 619B210 STEEL BEAM GUA 631E003 GUARDRAIL END 650A000 TOPSOIL 652A100 SEEDING 654A001 SOLID SODDING (654A001)	N BACKFILL, COMMERCIAL	CU YD	715	30	40	25	15	30	25	10	15	
301A012 CRUSHED AGGRE COMPACTED THIS COMPACT COM	IS OR SHEETING AND SHORING	EA	14		1	1	1		1	1	1	
401A000 BITUMINOUS TRE 424A340 SUPERPAVE BITL MAXIMUM AGGRE 424B666 AGGREGATE SUF 502A000 STEEL REINFORD 530A003 30" ROADWAY PIF 530A004 36" ROADWAY PIF 530A006 48" ROADWAY PIF 530A006 56" ROADWAY PIF 530A007 54" ROADWAY PIF 530B003 36" SPAN, 23" RIS 530B004 44" SPAN, 27" RIS 530B006 59" SPAN, 36" RIS 530B007 54" ROADWAY PIF 630A007 54" ROADWAY PIF 630A008 60" ROADWAY PIF 630A009 55" SPAN, 36" RIS 630B009 73" SPAN, 45" RIS 600A000 MOBILIZATION 610C001 LOOSE RIPRAP, CO 610D003 FILTER BLANKET, 619A004 36" ROADWAY PIF 619A204 36" ROADWAY PIF 619A207 48" ROADWAY PIF 619A207 48" ROADWAY PIF 619A208 54" ROADWAY PIF 619A209 60" ROADWAY PIF 619A206 48" ROADWAY PIF 619A207 48" ROADWAY PIF 619A208 54" ROADWAY PIF 619A209 50" ROADWAY PIF 619A209 54" ROADWAY PIF 619A308 54" ROADWAY PIF 619B019 44" SPAN, 27" RIS 619B271 59" SPAN, 36" RIS 619B271 59" SPAN, 36" RIS 619B299 44" SPAN, 27" RIS 619B318 44" SPAN, 27" RIS 620A000 MINOR STRUCTU 631C000 STEEL BEAM GUA 631E003 GUARDRAIL END 654A001 SOLID SODDING 6	ROCESSING	RDST	30	1.5	1.5	1.5	1.5	1.5	1.5	1.5	1.5	201
424A340 SUPERPAVE BITL MAXIMUM AGGRE ATE SIZE AGGREGATE SIZE AGGREGATE SUPERPAVE BITL AGGREGATE BITL AGGREAT BITL	GGREGATE BASE COURSE, TYPE B, PLANT MIXED, 6" ) THICKNESS	SQ YD	2580	90	75	80	60	110	80	75	90	
424A340 MAXIMUM AGGRE 424B666 SUPERPAVE BITL AGGREGATE SIZI 430B003 AGGREGATE SUP 502A000 STEEL REINFORD 530A003 30" ROADWAY PIR 530A004 36" ROADWAY PIR 530A006 48" ROADWAY PIR 530A006 60" ROADWAY PIR 530A008 60" ROADWAY PIR 530B003 36" SPAN, 23" RIS 530B004 44" SPAN, 27" RIS 530B006 59" SPAN, 36" RIS 530B006 59" SPAN, 36" RIS 530B008 73" SPAN, 45" RIS 600A000 MOBILIZATION 610C001 LOOSE RIPRAP, C 619A004 30" ROADWAY PIR 619A204 36" ROADWAY PIR 619A204 36" ROADWAY PIR 619A209 60" ROADWAY PIR 619A209 48" ROADWAY PIR 619A209 48" ROADWAY PIR 619B020 44" SPAN, 27" RIS 619B021 73" SPAN, 45" RIS 619B299 44" SPAN, 27" RIS 619B318 44" SPAN, 27" RIS 619B318 44" SPAN, 27" RIS 620A000 MINOR STRUCTU 631C000 STEEL BEAM GUA 631E003 GUARDRAIL END 652A100 SEEDING 654A001 SOLID SODDING 6	TREATMENT A	SQ YD	1240	90	75	80	60	110	80	75	90	
424B000 AGGREGATE SIZE 430B003 AGGREGATE SUF 502A000 STEEL REINFORC 530A003 30" ROADWAY PIF 530A004 36" ROADWAY PIF 530A006 48" ROADWAY PIF 530A007 54" ROADWAY PIF 530A008 60" ROADWAY PIF 530B003 36" SPAN, 23" RIS 530B004 44" SPAN, 27" RIS 530B006 59" SPAN, 36" RIS 530B006 59" SPAN, 36" RIS 530B008 73" SPAN, 45" RIS 600A000 MOBILIZATION 610C001 LOOSE RIPRAP, C 610D003 FILTER BLANKET, 619A004 30" ROADWAY PIF 619A204 36" ROADWAY PIF 619A204 36" ROADWAY PIF 619A209 60" ROADWAY PIF 619A209 60" ROADWAY PIF 619A209 64" ROADWAY PIF 619A209 67" ROADWAY PIF 619B203 73" SPAN, 27" RIS 619B271 59" SPAN, 36" RIS 619B289 44" SPAN, 27" RIS 619B290 44" SPAN, 27" RIS 619B218 44" SPAN, 27" RIS 619B218 44" SPAN, 27" RIS 620A000 MINOR STRUCTU 631C000 STEEL BEAM GUA 631E003 GUARDRAIL END 654A001 SOLID SODDING 6	BITUMINOUS CONCRETE WEARING SURFACE LAYER 1/2" GGREGATE SIZE MIX, ESAL RANGE A/B (220 LBS/SY)	TON	492	30	29	29	28	32	29	29	30	303
502A000 STEEL REINFORCE 530A003 30" ROADWAY PIR 530A006 48" ROADWAY PIR 530A007 54" ROADWAY PIR 530A007 54" ROADWAY PIR 530A008 60" ROADWAY PIR 530B003 36" SPAN, 23" RIS 530B004 44" SPAN, 27" RIS 530B006 59" SPAN, 36" RIS 530B008 73" SPAN, 45" RIS 600A000 MOBILIZATION 610C001 LOOSE RIPRAP, C 610D003 FILTER BLANKET, 619A004 30" ROADWAY PIR 619A204 36" ROADWAY PIR 619A207 48" ROADWAY PIR 619A209 60" ROADWAY PIR 619A206 48" ROADWAY PIR 619A207 48" ROADWAY PIR 619A208 54" ROADWAY PIR 619B019 44" SPAN, 27" RIS 619B023 73" SPAN, 45" RIS 619B271 59" SPAN, 36" RIS 619B299 44" SPAN, 27" RIS 619B299 44" SPAN, 27" RIS 619B318 44" SPAN, 27" RIS 620A000 MINOR STRUCTU 631C000 STEEL BEAM GUA 631E003 GUARDRAIL END 654A001 SOLID SODDING 6	BITUMINOUS CONCRETE LOWER BINDER LAYER, 1" MAXIMUM SIZE MIX, ESAL RANGE A/B (300 LBS/SY)	TON	703	45	43	44	41	48	44	43	45	
530A003 30" ROADWAY PIE 530A004 36" ROADWAY PIE 530A006 48" ROADWAY PIE 530A007 54" ROADWAY PIE 530A008 60" ROADWAY PIE 530B003 36" SPAN, 23" RIS 530B004 44" SPAN, 27" RIS 530B006 59" SPAN, 36" RIS 530B008 73" SPAN, 45" RIS 600A000 MOBILIZATION 610C001 LOOSE RIPRAP, 0 610D003 FILTER BLANKET, 619A004 30" ROADWAY PIE 619A204 36" ROADWAY PIE 619A207 48" ROADWAY PIE 619A207 48" ROADWAY PIE 619A208 60" ROADWAY PIE 619A209 60" ROADWAY PIE 619A209 60" ROADWAY PIE 619A206 48" ROADWAY PIE 619A207 48" ROADWAY PIE 619A207 48" ROADWAY PIE 619A208 54" ROADWAY PIE 619A209 60" ROADWAY PIE 619A209 48" ROADWAY PIE 619A209 48" ROADWAY PIE 619A208 54" ROADWAY PIE 619B019 44" SPAN, 27" RIS 619B291 44" SPAN, 27" RIS 619B299 44" SPAN, 27" RIS 619B218 44" SPAN, 27" RIS 620A000 MINOR STRUCTU 631E003 GUARDRAIL END 652A100 SEEDING 654A001 SOLID SODDING (	SURFACING (ALDOT #57)	TON	500	25	25	25	25	25	25	25	25	304
530A004 36" ROADWAY PIE 530A006 48" ROADWAY PIE 530A007 54" ROADWAY PIE 530A008 60" ROADWAY PIE 530B003 36" SPAN, 23" RIS 530B004 44" SPAN, 27" RIS 530B006 55" SPAN, 36" RIS 530B008 73" SPAN, 45" RIS 600A000 MOBILIZATION 610C001 LOOSE RIPRAP, C 610D003 FILTER BLANKET, 619A004 36" ROADWAY PIE 619A207 48" ROADWAY PIE 619A207 48" ROADWAY PIE 619A207 48" ROADWAY PIE 619A207 48" ROADWAY PIE 619A208 54" ROADWAY PIE 619A209 60" ROADWAY PIE 619A266 48" ROADWAY PIE 619A308 54" ROADWAY PIE 619B019 44" SPAN, 27" RIS 619B271 59" SPAN, 36" RIS 619B271 59" SPAN, 36" RIS 619B29 44" SPAN, 27" RIS 619B318 44" SPAN, 27" RIS 620A000 MINOR STRUCTU 631E003 GUARDRAIL END 652A100 SEEDING 654A001 SOLID SODDING (654A001)	ORCEMENT	LBS	27231	2376	1982	1735		2889	1495	1204	1116	
530A006 48" ROADWAY PIE 530A007 54" ROADWAY PIE 530A008 60" ROADWAY PIE 530B003 36" SPAN, 23" RIS 530B004 44" SPAN, 27" RIS 530B006 59" SPAN, 36" RIS 530B008 73" SPAN, 45" RIS 600A000 MOBILIZATION 610C001 LOOSE RIPRAP, C 610D003 FILTER BLANKET, 619A004 36" ROADWAY PIE 619A204 36" ROADWAY PIE 619A207 48" ROADWAY PIE 619A208 48" ROADWAY PIE 619A208 48" ROADWAY PIE 619A208 48" ROADWAY PIE 619A208 54" ROADWAY PIE 619B019 44" SPAN, 27" RIS 619B271 59" SPAN, 36" RIS 619B299 44" SPAN, 27" RIS 619B318 44" SPAN, 27" RIS 620A000 MINOR STRUCTU 631E003 GUARDRAIL END 652A100 SEEDING 654A001 SOLID SODDING (	Y PIPE (CLASS 3 R.C.)	LF	40									
530A007 54" ROADWAY PIE 530A008 60" ROADWAY PIE 530B003 36" SPAN, 23" RIS 530B004 44" SPAN, 27" RIS 530B006 59" SPAN, 36" RIS 530B008 73" SPAN, 45" RIS 600A000 MOBILIZATION 610C001 LOOSE RIPRAP, C 610D003 FILTER BLANKET, 619A004 36" ROADWAY PIE 619A204 36" ROADWAY PIE 619A207 48" ROADWAY PIE 619A209 60" ROADWAY PIE 619A206 48" ROADWAY PIE 619A207 48" ROADWAY PIE 619A208 54" ROADWAY PIE 619A209 64" ROADWAY PIE 619A209 64" ROADWAY PIE 619A209 54" ROADWAY PIE 619B023 73" SPAN, 27" RIS 619B271 59" SPAN, 36" RIS 619B271 59" SPAN, 36" RIS 619B318 44" SPAN, 27" RIS 619B318 44" SPAN, 27" RIS 620A000 MINOR STRUCTU 631C000 STEEL BEAM GUA 631E003 GUARDRAIL END 652A100 SEEDING 654A001 SOLID SODDING (	Y PIPE (CLASS 3 R.C.)	LF	80				80					
530A008 60" ROADWAY PIE 530B003 36" SPAN, 23" RIS 530B004 44" SPAN, 27" RIS 530B006 59" SPAN, 36" RIS 530B008 73" SPAN, 45" RIS 600A000 MOBILIZATION 610C001 LOOSE RIPRAP, 0 610D003 FILTER BLANKET, 619A004 30" ROADWAY PIE 619A204 36" ROADWAY PIE 619A207 48" ROADWAY PIE 619A209 60" ROADWAY PIE 619A206 48" ROADWAY PIE 619A206 48" ROADWAY PIE 619A207 48" ROADWAY PIE 619A208 54" ROADWAY PIE 619A209 60" ROADWAY PIE 619B019 44" SPAN, 27" RIS 619B271 59" SPAN, 36" RIS 619B299 44" SPAN, 27" RIS 619B318 44" SPAN, 27" RIS 620A000 MINOR STRUCTU 631C000 STEEL BEAM GUA 631E003 GUARDRAIL END 652A100 SEEDING 654A001 SOLID SODDING (	Y PIPE (CLASS 3 R.C.)	LF	520					160				
530B003 36" SPAN, 23" RIS 530B004 44" SPAN, 27" RIS 530B006 59" SPAN, 36" RIS 530B008 73" SPAN, 45" RIS 600A000 MOBILIZATION 610C001 LOOSE RIPRAP, 0 610D003 FILTER BLANKET, 619A004 30" ROADWAY PIR 619A204 36" ROADWAY PIR 619A207 48" ROADWAY PIR 619A209 60" ROADWAY PIR 619A209 60" ROADWAY PIR 619A209 48" ROADWAY PIR 619A206 48" ROADWAY PIR 619A207 48" ROADWAY PIR 619A208 54" ROADWAY PIR 619A209 50" ROADWAY PIR 619A209 48" ROADWAY PIR 619B019 44" SPAN, 27" RIS 619B203 73" SPAN, 45" RIS 619B297 44" SPAN, 27" RIS 619B299 44" SPAN, 27" RIS 619B299 44" SPAN, 27" RIS 619B218 44" SPAN, 27" RIS 620A000 MINOR STRUCTU 631C000 STEEL BEAM GUA 631E003 GUARDRAIL END 652A100 SEEDING 654A001 SOLID SODDING 6	Y PIPE (CLASS 3 R.C.)	LF	120									
530B004 44" SPAN, 27" RIS 530B006 59" SPAN, 36" RIS 530B008 73" SPAN, 45" RIS 600A000 MOBILIZATION 610C001 LOOSE RIPRAP, C 610D003 FILTER BLANKET, 619A004 36" ROADWAY PIR 619A204 36" ROADWAY PIR 619A207 48" ROADWAY PIR 619A207 64" ROADWAY PIR 619A208 64" ROADWAY PIR 619A209 65" ROADWAY PIR 619A209 64" ROADWAY PIR 619A209 54" ROADWAY PIR 619A206 48" ROADWAY PIR 619A207 48" ROADWAY PIR 619A207 48" ROADWAY PIR 619A208 54" ROADWAY PIR 619A308 54" ROADWAY PIR 619B019 44" SPAN, 27" RIS 619B023 73" SPAN, 45" RIS 619B291 59" SPAN, 36" RIS 619B291 44" SPAN, 27" RIS 619B318 44" SPAN, 27" RIS 620A000 MINOR STRUCTU 631C000 STEEL BEAM GUA 631E003 GUARDRAIL END 650A000 TOPSOIL 652A100 SEEDING	Y PIPE (CLASS 3 R.C.)	LF	80						80			
530B006 59" SPAN, 36" RIS 530B008 73" SPAN, 45" RIS 600A000 MOBILIZATION 610C001 LOOSE RIPRAP, C 610D003 FILTER BLANKET, 619A004 36" ROADWAY PIR 619A204 36" ROADWAY PIR 619A207 48" ROADWAY PIR 619A207 60" ROADWAY PIR 619A208 48" ROADWAY PIR 619A266 48" ROADWAY PIR 619A266 48" ROADWAY PIR 619A276 48" ROADWAY PIR 619B019 44" SPAN, 27" RIS 619B023 73" SPAN, 45" RIS 619B271 59" SPAN, 36" RIS 619B271 59" SPAN, 36" RIS 619B289 44" SPAN, 27" RIS 619B29 44" SPAN, 27" RIS 620A000 MINOR STRUCTU 631C000 STEEL BEAM GUA 631E003 GUARDRAIL END 650A000 TOPSOIL 652A100 SEEDING	" RISE ROADWAY PIPE (CLASS 3 R.C.)	LF	120		ļ	120					120	
530B008 73" SPAN, 45" RIS 600A000 MOBILIZATION 610C001 LOOSE RIPRAP, C 610D003 FILTER BLANKET, 619A004 36" ROADWAY PIR 619A204 36" ROADWAY PIR 619A207 48" ROADWAY PIR 619A209 66" ROADWAY PIR 619A266 48" ROADWAY PIR 619A276 48" ROADWAY PIR 619A308 54" ROADWAY PIR 619B019 44" SPAN, 27" RIS 619B023 73" SPAN, 45" RIS 619B271 59" SPAN, 36" RIS 619B291 44" SPAN, 27" RIS 619B299 44" SPAN, 27" RIS 619B299 44" SPAN, 27" RIS 619B290 MINOR STRUCTU 631C000 STEEL BEAM GUA 631E003 GUARDRAIL END 650A000 TOPSOIL 652A100 SEEDING	" RISE ROADWAY PIPE (CLASS 3 R.C.)	LF.	392	100						80	120	
600A000 MOBILIZATION 610C001 LOOSE RIPRAP, C 610D003 FILTER BLANKET, 619A004 30" ROADWAY PIR 619A204 36" ROADWAY PIR 619A207 48" ROADWAY PIR 619A209 60" ROADWAY PIR 619A266 48" ROADWAY PIR 619A276 48" ROADWAY PIR 619A308 54" ROADWAY PIR 619B019 44" SPAN, 27" RIS 619B023 73" SPAN, 45" RIS 619B271 59" SPAN, 36" RIS 619B271 59" SPAN, 36" RIS 619B289 44" SPAN, 27" RIS 619B318 44" SPAN, 27" RIS 620A000 MINOR STRUCTU 631C000 STEEL BEAM GUA 631E003 GUARDRAIL END 650A000 TOPSOIL 652A100 SEEDING	" RISE ROADWAY PIPE (CLASS 3 R.C.)	LF	480	120	80					00		
610C001 LOOSE RIPRAP, C 610D003 FILTER BLANKET, 619A004 30" ROADWAY PIF 619A204 36" ROADWAY PIF 619A207 48" ROADWAY PIF 619A209 60" ROADWAY PIF 619A266 48" ROADWAY PIF 619A276 48" ROADWAY PIF 619A308 54" ROADWAY PIF 619B019 44" SPAN, 27" RIS 619B023 73" SPAN, 45" RIS 619B271 59" SPAN, 36" RIS 619B291 44" SPAN, 27" RIS 619B299 44" SPAN, 27" RIS 619B218 44" SPAN, 27" RIS 620A000 MINOR STRUCTU 631C000 STEEL BEAM GUA 631E003 GUARDRAIL END 650A000 TOPSOIL 652A100 SEEDING	" RISE ROADWAY PIPE (CLASS 3 R.C.)	LF	104	-								
610D003 FILTER BLANKET, 619A004 30" ROADWAY PIE 619A204 36" ROADWAY PIE 619A207 48" ROADWAY PIE 619A209 60" ROADWAY PIE 619A266 48" ROADWAY PIE 619A276 48" ROADWAY PIE 619A308 54" ROADWAY PIE 619B019 44" SPAN, 27" RIS 619B023 73" SPAN, 45" RIS 619B271 59" SPAN, 36" RIS 619B299 44" SPAN, 27" RIS 619B318 44" SPAN, 27" RIS 620A000 MINOR STRUCTU 631C000 STEEL BEAM GUA 631E003 GUARDRAIL END 652A100 SEEDING 654A001 SOLID SODDING (		LS	1 1	05	C.F.	G.F.	45	135	75	75	75	
619A004 30" ROADWAY PIE 619A204 36" ROADWAY PIE 619A207 48" ROADWAY PIE 619A209 60" ROADWAY PIE 619A266 48" ROADWAY PIE 619A276 48" ROADWAY PIE 619A308 54" ROADWAY PIE 619B019 44" SPAN, 27" RIS 619B023 73" SPAN, 45" RIS 619B271 59" SPAN, 36" RIS 619B299 44" SPAN, 27" RIS 619B318 44" SPAN, 27" RIS 620A000 MINOR STRUCTU 631C000 STEEL BEAM GUA 631E003 GUARDRAIL END 650A000 TOPSOIL 652A100 SEEDING 654A001 SOLID SODDING (		TON	1410	65 65	65	65 65	45	135	75	75	75	
619A204 36" ROADWAY PIE 619A207 48" ROADWAY PIE 619A209 60" ROADWAY PIE 619A266 48" ROADWAY PIE 619A276 48" ROADWAY PIE 619A276 48" ROADWAY PIE 619B019 44" SPAN, 27" RIS 619B023 73" SPAN, 45" RIS 619B271 59" SPAN, 36" RIS 619B299 44" SPAN, 27" RIS 619B318 44" SPAN, 27" RIS 620A000 MINOR STRUCTU 631C000 STEEL BEAM GU/ 631E003 GUARDRAIL END 650A000 TOPSOIL 652A100 SEDING	The state of the s	SQ YD	1410	05	05	05	45	100	13	10	+	
619A207 48" ROADWAY PIE 619A209 60" ROADWAY PIE 619A266 48" ROADWAY PIE 619A276 48" ROADWAY PIE 619A276 48" ROADWAY PIE 619B019 44" SPAN, 27" RIS 619B023 73" SPAN, 45" RIS 619B271 59" SPAN, 36" RIS 619B299 44" SPAN, 27" RIS 619B318 44" SPAN, 27" RIS 620A000 MINOR STRUCTU 631C000 STEEL BEAM GU/ 631E003 GUARDRAIL END 650A000 TOPSOIL 652A100 SEEDING 654A001 SOLID SODDING (	Y PIPE END TREATMENT, CLASS 1 Y PIPE END TREATMENT, CLASS 1 (DOUBLE LINE)	EA EA	2		-		2					
619A209 60" ROADWAY PIE 619A266 48" ROADWAY PIE 619A276 48" ROADWAY PIE 619A308 54" ROADWAY PIE 619B019 44" SPAN, 27" RIS 619B023 73" SPAN, 45" RIS 619B271 59" SPAN, 36" RIS 619B299 44" SPAN, 27" RIS 619B299 44" SPAN, 27" RIS 619B318 44" SPAN, 27" RIS 620A000 MINOR STRUCTU 631C000 STEEL BEAM GU/ 631E003 GUARDRAIL END 650A000 TOPSOIL 652A100 SEEDING 654A001 SOLID SODDING	Y PIPE END TREATMENT, CLASS 1 (DOUBLE LINE)	EA	1	<del> </del>								
619A266 48" ROADWAY PII 619A276 48" ROADWAY PII 619A308 54" ROADWAY PII 619B019 44" SPAN, 27" RIS 619B023 73" SPAN, 45" RIS 619B271 59" SPAN, 36" RIS 619B299 44" SPAN, 27" RIS 619B318 44" SPAN, 27" RIS 620A000 MINOR STRUCTU 631C000 STEEL BEAM GU/ 631E003 GUARDRAIL END 650A000 TOPSOIL 652A100 SEEDING 654A001 SOLID SODDING (	Y PIPE END TREATMENT, CLASS 1 (DOUBLE LINE)	EA	+						1			
619A276 48" ROADWAY PIF 619A308 54" ROADWAY PIF 619B019 44" SPAN, 27" RIS 619B023 73" SPAN, 45" RIS 619B271 59" SPAN, 36" RIS 619B299 44" SPAN, 27" RIS 619B318 44" SPAN, 27" RIS 620A000 MINOR STRUCTU 631C000 STEEL BEAM GU/ 631E003 GUARDRAIL END 650A000 TOPSOIL 652A100 SEEDING 654A001 SOLID SODDING	Y PIPE END TREATMENT, CLASS 1 (FOUR LINE)	EA	1 1									
619A308 54" ROADWAY PIF 619B019 44" SPAN, 27" RIS 619B023 73" SPAN, 45" RIS 619B271 59" SPAN, 36" RIS 619B299 44" SPAN, 27" RIS 619B318 44" SPAN, 27" RIS 620A000 MINOR STRUCTU 631C000 STEEL BEAM GU/ 631E003 GUARDRAIL END 650A000 TOPSOIL 652A100 SEEDING 654A001 SOLID SODDING	Y PIPE END TREATMENT, CLASS 1 (TRIPLE LINE)	EA	1 1			1						
619B019 44" SPAN, 27" RIS 619B023 73" SPAN, 45" RIS 619B271 59" SPAN, 36" RIS 619B299 44" SPAN, 27" RIS 619B318 44" SPAN, 27" RIS 620A000 MINOR STRUCTU 631C000 STEEL BEAM GU/ 631E003 GUARDRAIL END 650A000 TOPSOIL 652A100 SEEDING	Y PIPE END TREATMENT, CLASS 1 (TRIPLE LINE)	EA	1									
619B271 59" SPAN, 36" RIS 619B299 44" SPAN, 27" RIS 619B318 44" SPAN, 27" RIS 620A000 MINOR STRUCTU 631C000 STEEL BEAM GU/ 631E003 GUARDRAIL END 650A000 TOPSOIL 652A100 SEEDING 654A001 SOLID SODDING	" RISE ROADWAY PIPE END TREATMENT, CLASS 1	EA	3									
619B299 44" SPAN, 27" RIS 619B318 44" SPAN, 27" RIS 620A000 MINOR STRUCTU 631C000 STEEL BEAM GU/ 631E003 GUARDRAIL END 650A000 TOPSOIL 652A100 SEEDING 654A001 SOLID SODDING	" RISE ROADWAY PIPE END TREATMENT, CLASS 1	EA	1									
619B318 44" SPAN, 27" RIS 620A000 MINOR STRUCTU 631C000 STEEL BEAM GU/ 631E003 GUARDRAIL END 650A000 TOPSOIL 652A100 SEEDING 654A001 SOLID SODDING	" RISE ROADWAY PIPE END TREATMENT, CLASS 1 (DOUBLE LINE)	EA	2							1		
620A000 MINOR STRUCTU 631C000 STEEL BEAM GU/ 631E003 GUARDRAIL END 650A000 TOPSOIL 652A100 SEEDING 654A001 SOLID SODDING	" RISE ROADWAY PIPE END TREATMENT, CLASS 1 (TRIPLE LINE)	EA	1								11	<b></b>
631C000 STEEL BEAM GUA 631E003 GUARDRAIL END 650A000 TOPSOIL 652A100 SEEDING 654A001 SOLID SODDING	" RISE ROADWAY PIPE END TREATMENT, CLASS 1 (FOUR LINE)	EA	2							1		
631E003 GUARDRAIL END 650A000 TOPSOIL 652A100 SEEDING 654A001 SOLID SODDING	ICTURE CONCRETE	CU YD	219	19	17	14		24	13	10	9	
650A000 TOPSOIL 652A100 SEEDING 654A001 SOLID SODDING (	GUARDRAIL, CLASS A, TYPE 1 RESET	LF	140					140			-	
652A100 SEEDING 654A001 SOLID SODDING (	END ANCHOR, TYPE 13 RESET	EA	4		1.			4	- 00	15	16	
654A001 SOLID SODDING		CU YD	490	30	12	25	20	36	20	15	0.1	
		ACRE	2.1	0.1	0.1	0.1	0.1	0.1	0.1	0.1	20	
005 1000 100	NG (BERMUDA)	SQ YD	388	34	16	16	12	14	24	18 185	165	305, 500
665J002 SILT FENCE		LF	4045	180	170	215	120	190	170	100	100	300, 300
665L000 FLOATING BASIN		LF	56	<del></del>	20		36	100	170	105	165	305, 500
6650001 SILT FENCE REM	REMOVAL	LF	4045	180	170	215	120	190	170	185	165	300, 500
665Q002 WATTLE		LF	2100	100	100	100	100	100	100	100	100	<del> </del>
680A001 GEOMETRIC CON		LS	1		<b>_</b>	ļ						701
	CONTROLS	LS	1									701
742A003 PORTABLE CHAN	RAFFIC STRIPE SCHEME	EA	4						1			

F	PLAN SUBMITTAL		BALDWIN COUNTY	SHEET TITLE SUMMARY OF	ROUTE
DATE: 08/06/2015	,	THE REAL PROPERTY.	HIGHWAY DEPARTMENT	QUANTITIES	

# SUMMARY OF QUANTITIES

REFERENCE	FISCAL	SHEET
PROJECT NO	YEAR	NO
BCP#0218014	2016	

ITEM	DESCRIPTION	UNIT	BC300-055	BC300-228	BC300-252	BC300-053	BC300-182	BC300-198	BC300-224	PROJECT NOTES
206C023	REMOVING RIP RAP	SQ YD	270					34		401
206D000	REMOVING PIPE	LF	36	40	48	36	86	80	40	300
206E000	REMOVING HEADWALLS	EA				2				301
210A000	UNCLASSIFIED EXCAVATION	CU YD	220	270	220	300	340	400	420	301, 302
210C000	MUCK EXCAVATION & REMOVAL	CU YD	35	35	30	40	40	40	30	
	BORROW EXCAVATION (LOOSE TRUCKBED MEASUREMENT)(A-2-4(0) OR			270	220	300	340	400	420	
210D022	A-4(0)	CU YD	220							
214B001	FOUNDATION BACKFILL, COMMERCIAL	CU YD	45	15	20	95	50	110	40	
215B000	COFFERDAMS OR SHEETING AND SHORING	EA		1	1	1	11	1	<u> </u>	201
230A000	ROADBED PROCESSING	RBST	1.5	1.5	1.5	1.5	1.5	1.5	1.5	201
301A012	CRUSHED AGGREGATE BASE COURSE, TYPE B, PLANT MIXED, 6" COMPACTED THICKNESS	SQ YD	60	75	60	70	100	330	350	
401A000	BITUMINOUS TREATMENT A	SQ YD	60	75	60	70	100			
	SUPERPAVE BITUMINOUS CONCRETE WEARING SURFACE 1/2" MAXIMUM									303
424A340	AGGREGATE SIZE MIX, ESAL RANGE A/B (220 LBS/SY)	TON	30	32	30	31	34			303
424B666	SUPERPAVE BITUMINOUS CONCRETE LOWER BINDER LAYER, 1" MAXIMUM	TON	41	44	40	42	47			
	AGGREGATE SIZE MIX, ESAL RANGE A/B (300 LBS/SY)			25	25	25	25	25	25	304
430B003	AGGREGATE SURFACING (ALDOT #57)	TON	25		762	1262	25	1579	1482	304
502A000	STEEL REINFORCEMENT	LB	1373	1101	40	1202		1379	1402	
530A003	30" ROADWAY PIPE (CLASS 3 R.C.)	LF			40					
530A004	36" ROADWAY PIPE (CLASS 3 R.C.)	LF				80			160	
530A006	48" ROADWAY PIPE (CLASS 3 R.C.)	LF LF				80		120	100	
530A007	54" ROADWAY PIPE (CLASS 3 R.C.)	<u>LF</u>						120		
530A008	60" ROADWAY PIPE (CLASS 3 R.C.)	<u>LF</u>						<b></b>		
530B003	36" SPAN, 23" RISE ROADWAY PIPE (CLASS 3 R.C.)	<u>LF</u>					100			
530B004	44" SPAN, 27" RISE ROADWAY PIPE (CLASS 3 R.C.)	<u>LF</u>		00			192			
530B006	59" SPAN, 36" RISE ROADWAY PIPE (CLASS 3 R.C.)	<u>LF</u>	40	80					-	
530B008	73" SPAN, 45" RISE ROADWAY PIPE (CLASS 3 R.C.)	LF	40							-
600A000	MOBILIZATION	LS		0.5	50	0.5	C.F.	50	105	-
610C001	LOOSE RIPRAP, CLASS 2	TON	90	65	50	85	65		105	
610D003	FILTER BLANKET, GEOTEXTILE	SQ YD	90	65	50	85	65	50	103	
619A004	30" ROADWAY PIPE END TREATMENT, CLASS 1	EA			1			<b>_</b>	<del></del>	
619A204	36" ROADWAY PIPE END TREATMENT, CLASS 1 (DOUBLE LINE)	EA						ļ		
619A207	48" ROADWAY PIPE END TREATMENT, CLASS 1 (DOUBLE LINE)	EA				11				
619A209	60" ROADWAY PIPE END TREATMENT, CLASS 1 (DOUBLE LINE)	EA							1	
619A266	48" ROADWAY PIPE END TREATMENT, CLASS 1 (FOUR LINE)	EA		ļ					<u> </u>	
619A276	48" ROADWAY PIPE END TREATMENT, CLASS 1 (TRIPLE LINE)	EA						1		
619A308	54" ROADWAY PIPE END TREATMENT, CLASS 1 (TRIPLE LINE)	EA		<b></b>				<del> </del>		
619B019	44" SPAN, 27" RISE ROADWAY PIPE END TREATMENT, CLASS 1	EA	<u> </u>					<b>-</b>	-	-
619B023	73" SPAN, 45" RISE ROADWAY PIPE END TREATMENT, CLASS 1	EA	11					<del> </del>		
619B271	59" SPAN, 36" RISE ROADWAY PIPE END TREATMENT, CLASS 1 (DOUBLE LINE)	EA		1						-
619B299	44" SPAN, 27" RISE ROADWAY PIPE END TREATMENT, CLASS 1 (TRIPLE LINE)	EA				ļ	1	-		
619B318	44" SPAN, 27" RISE ROADWAY PIPE END TREATMENT, CLASS 1 (FOUR LINE)	EA	10		7	10	2	12	11	<del> </del>
620A000	MINOR STRUCTURE CONCRETE	CU YD	10	9	7	10	ļ	12	+11	-
631C000	STEEL BEAM GUARDRAIL, CLASS A, TYPE 1 RESET	LF.	<b></b>		<b>_</b>	<del> </del>		<del> </del>	-	
631E003	GUARDRAIL END ANCHOR, TYPE 13 RESET	EA	- 00	- 20		60	20	20	16	+
650A000	TOPSOIL	CU YD	20	30	20	60	20	0.1	0.1	1
652A100	SEEDING	ACRE	0.1	0.1	0.1	0.2	0.1			-
654A001	SOLID SODDING (BERMUDA)	SQ YD	14	20	22	14	20	25	26	305, 500
665J002	SILT FENCE	LF	190	220	270	310	190	240	190	300, 500
665L000	FLOATING BASIN BOOM	LF				<u> </u>		<b>_</b>		005 500
6650001	SILT FENCE REMOVAL	LF	190	220	270	310	190	240	190	305, 500
665Q002	WATTLE	LF	100	100	100	200	100	100	100	
680A001	GEOMETRIC CONTROLS	LS								
701B100	ROADWAY TRAFFIC STRIPE SCHEME	LS								701
742A003	PORTABLE CHANGEABLE MESSAGE SIGN, TYPE 3	EA								
740A000	TRAFFIC CONTROL SCHEME	LS								702

			SHEET TITLE	T BOUTE
	PLAN SUBMITTAL	BALDWIN COUNTY	SUMMARY OF	ROUTE
DATE: 08/06/2015		HIGHWAY DEPARTMENT	QUANTITIES	

# SUMMARY OF QUANTITIES

evi node	REFERENCE	FISCAL	SHEET	
	PROJECT NO	YEAR	NO	
	BCP#0218014	2016	3B	


ITEM	DESCRIPTION	UNIT	BC300-043	BC300-121	BC300-246	BC300-248	BC300-283	PROJECT NOTES
206C023	REMOVING RIP RAP	SQ YD						401
206D000	REMOVING PIPE	LF	28	32	36	50	80	300
206E000	REMOVING HEADWALLS	EA						301
210A000	UNCLASSIFIED EXCAVATION	CU YD	300	330	140	160	440	301, 302
210C000	MUCK EXCAVATION & REMOVAL	CU YD	60	40		30	30	
210D022	BORROW EXCAVATION (LOOSE TRUCKBED MEASUREMENT)(A-2-4(0) OR			***************************************	440	7,410,000		
2100022	A-4(0)	CU YD	300	330	140	160	440	
214B001	FOUNDATION BACKFILL, COMMERCIAL	CU YD	30	30	30	30	30	
215B000	COFFERDAMS OR SHEETING AND SHORING,	EA	1	1			1	
230A000	ROADBED PROCESSING	RBST	1.5	1.5	1.5	1.5	1.5	201
301A012	CRUSHED AGGREGATE BASE COURSE, TYPE B, PLANT MIXED, 6" COMPACTED THICKNESS	SQ YD	340	320	60	60	95	
401A000	BITUMINOUS TREATMENT A	SQ YD			60	60	95	
424A340	SUPERPAVE BITUMINOUS CONCRETE WEARING SURFACE 1/2" MAXIMUM AGGREGATE SIZE MIX, ESAL RANGE A/B (220 LBS/SY)	TON			35	32	32	303
424B666	SUPERPAVE BITUMINOUS CONCRETE LOWER BINDER LAYER, 1" MAXIMUM AGGREGATE SIZE MIX, ESAL RANGE A/B (300 LBS/SY)	TON			48	44	44	<del></del>
430B003	AGGREGATE SURFACING (ALDOT #57)	TON	25	25	25	25	25	304
502A000	STEEL REINFORCEMENT	LB	2494	1514		580	2287	
530A003	30" ROADWAY PIPE (CLASS 3 R.C.)	LF	1					
530A004	36" ROADWAY PIPE (CLASS 3 R.C.)	LF	1					
530A006	48" ROADWAY PIPE (CLASS 3 R.C.)	LF		120				******
530A007	54" ROADWAY PIPE (CLASS 3 R.C.)	LF						
530A008	60" ROADWAY PIPE (CLASS 3 R.C.)	LF	-					
530B003	36" SPAN, 23" RISE ROADWAY PIPE (CLASS 3 R.C.)	LF	T					
530B004	44" SPAN, 27" RISE ROADWAY PIPE (CLASS 3 R.C.)	LF	1		40	40		
530B006	59" SPAN, 36" RISE ROADWAY PIPE (CLASS 3 R.C.)	LF					120	
530B008	73" SPAN, 45" RISE ROADWAY PIPE (CLASS 3 R.C.)	LF	64				120	
600A000	MOBILIZATION	LS			***************************************			eminaliseto Aconstanto
610C001	LOOSE RIPRAP, CLASS 2	TON	75	85	50	40	50	
610D003	FILTER BLANKET, GEOTEXTILE	SQ YD	75	85	50	40	50	- Anna Carlotte
619A004	30" ROADWAY PIPE END TREATMENT, CLASS 1	EA						<del></del>
619A204	36" ROADWAY PIPE END TREATMENT, CLASS 1 (DOUBLE LINE)	EA						
619A207	48" ROADWAY PIPE END TREATMENT, CLASS 1 (DOUBLE LINE)	EA						
619A209	60" ROADWAY PIPE END TREATMENT, CLASS 1 (DOUBLE LINE)	EA						
619A266	48" ROADWAY PIPE END TREATMENT, CLASS 1 (FOUR LINE)	EA						
619A276	48" ROADWAY PIPE END TREATMENT, CLASS 1 (TRIPLE LINE)	EA		1				
619A308	54" ROADWAY PIPE END TREATMENT, CLASS 1 (TRIPLE LINE)	EA						
619B019	44" SPAN, 27" RISE ROADWAY PIPE END TREATMENT, CLASS 1	EA			2	1		
619B023	73" SPAN, 45" RISE ROADWAY PIPE END TREATMENT, CLASS 1	EA						
619B271	59" SPAN, 36" RISE ROADWAY PIPE END TREATMENT, CLASS 1 (DOUBLE LINE)	EA						
619B299	44" SPAN, 27" RISE ROADWAY PIPE END TREATMENT, CLASS 1 (TRIPLE LINE)	EA						
619B318	44" SPAN, 27" RISE ROADWAY PIPE END TREATMENT, CLASS 1 (FOUR LINE)	EA						
620A000	MINOR STRUCTURE CONCRETE	CU YD	19	12		5	18	
631C000	STEEL BEAM GUARDRAIL, CLASS A, TYPE 1 RESET	LF						
631E003	GUARDRAIL END ANCHOR, TYPE 13 RESET	EA						
650A000	TOPSOIL	CU YD	20	30	20	20	40	
652A100	SEEDING	ACRE	0.1	0.1	0.1	0.1	0.1	
654A001	SOLID SODDING (BERMUDA)	SQ YD	25	16	14	15	23	
665J002	SILT FENCE	LF	200	200	230	210	200	305, 500
665L000	FLOATING BASIN BOOM	LF						
6650001	SILT FENCE REMOVAL	LF	200	200	230	210	200	305, 500
665Q002	WATTLE	LF	100	100	100	100	100	
680A001	GEOMETRIC CONTROLS	LS						
701B100	ROADWAY TRAFFIC STRIPE SCHEME	LS			,			701
742A003	PORTABLE CHANGEABLE MESSAGE SIGN, TYPE 3	EA						
740A000	TRAFFIC CONTROL SCHEME	LS						702

	PLAN SUBMITTAL	BALDWIN COUNTY
TE: 08/06/2015		HIGHWAY DEPARTMENT

SHEET TITLE	ROUTE
SUMMARY OF	
QUANTITIES	

# TEMPORARY TRAFFIC CONTROL PLAN

REFERENCE FISCAL SHEET NO BCP0218014 2016 37

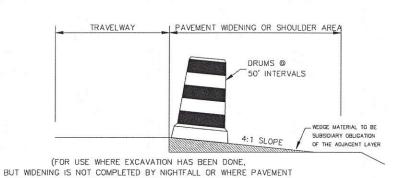


### TYPICAL FOR DROP-OFF AT EDGE OF PAVEMENT

NOTE: THE CONTRACTOR IS TO CONSTRUCT A WEDGE OF UNCLASSIFIED EXCAVATION OR CRUSHED AGGREGATE BASE. THE COST OF PLACING AND REMOVAL SHALL BE A SUBSIDIARY OBLIGATION OF THE ADJACENT LAYER.

CHANNELIZING DRUMS SHALL BE PLACED AT 50 FT INTERVALS.


DROP OFF OF RESURFACING PROJECTS IS 3" OR MORE AT NIGHTFALL)

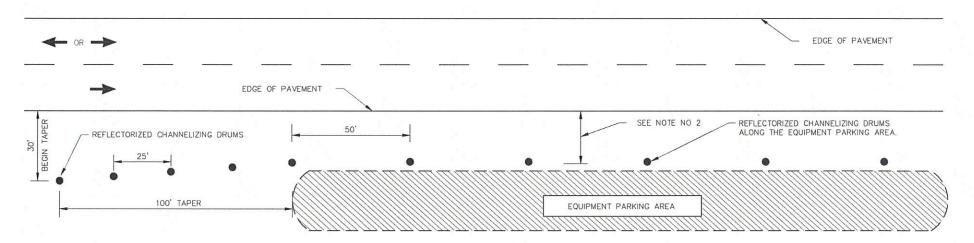


#### NOTES:

- 1. SEE ALDOT'S GENERAL TRAFFIC CONTROL PLAN NOTE NO. 702.
- 2. DRUMS TO BE AS FAR AS PRACTICAL FROM EDGE OF PAVEMENT, MINIMUM DESIRABLE DISTANCE IS 15 FEET FOR FREEWAY TYPE FACILITIES. AND 10 FEET FOR OTHER FACILITIES. FOR UNUSUAL CONDITIONS, SUCH AS SPECIAL EQUIPMENT OR LIMITED AVAILABLE SPACE, DIMENSIONS LESS THAN DESIRABLE SHALL BE AS DIRECTED BY THE FINISHEEP.
- ALL DEVICES TO BE FURNISHED BY THE CONTRACTOR WITHOUT COST TO THE ALDOT.

#### DELINEATING DETAIL FOR EQUIPMENT PARKING OR STORING AREA

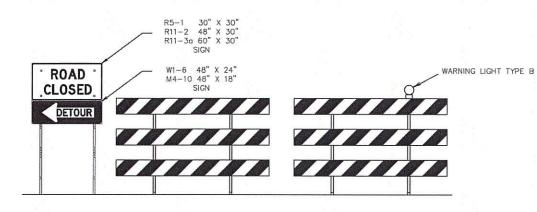

DETAILS FOR TYPICAL PLACEMENT OF TYPE
III BARRICADES INSIDE OF CLEAR ZONE

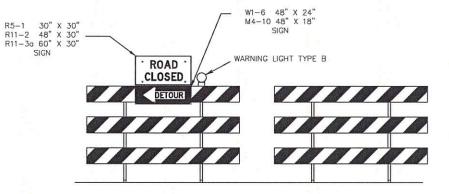

DETAILS FOR TYPICAL PLACEMENT OF TYPE
III BARRICADES OUTSIDE OF CLEAR ZONE

#### **NOTES**

- 1. SLOPE OF STRIPES ON BARRICADES SHALL BE IN ACCORDANCE WITH SECTION 6F.68 OF THE MUTCH AND DRAWING B-107-2.
- 2. IF SIGNS ARE REQUIRED TO BE USED IN CONJUNCTION WITH TYPE III BARRICADES TO BE PLACED INSIDE THE CLEAR ZONE, THEY SHALL BE POST MOUNTED TO THE SIDE OF THE BARRICADES AS SHOWN.
- 3. IF ROAD CLOSED OR DETOUR SIGNS ARE REQUIRED TO BE USED WITH TYPE III BARRICADES TO BE PLACED OUTSIDE THE CLEAR ZONE, THEY SHALL BE PLACED ON THE TOP OF THE BARRICADES NEAREST THE DETOUR.

#### SEQUENCE OF CONSTRUCTION

703 CONTRACTOR WILL BEGIN WORK
ON SITES BC300-014,
BC300-231, & BC300-024
FIRST TO ENSURE SITES ARE
COMPLETED AS EXPEDITIOUSLY
AS POSSIBLE FOLLOWING THE
NOTICE TO PROCEED.

--SPECIFICATIONS-CURRENT ALABAMA DEPARTMENT OF TRANSPORTATION

THIS DRAWING PEPPRESENTS DESIGNS PREPARED FOR USE BY THE ALABAMA DEPARTMENT OF TRANSPORTATION AND IS NOT TO BE COPIED, REPODUCED, ALTREDO, OR USED BY ANYONE, OR ANY ORGANIZATION, WHOUIT THE EXPRESSED WRITTEN CONSENT OF THE ALABAMA DEPARTMENT OF TRANSPORTATION REPRESENTATIVE AUTHORIZED TO APPROVE THIS USE. ANYONE MAKING UNAUTHORIZED USE OF THIS DRAWING MAY BE PROSECUTED TO THE FULLEST EXTENT OF THE LAW.

REVISIONS



ALABAMA DEPARTMENT OF TRANSPORTATION 1409 COLISEUM BOULEVARD MONTGOMERY, AL 36130-3050

2001

STANDARD DETAILS FOR TRAFFIC CONTROL PLANS

DATE DRAWN 9/8/2014

SPECIAL PROJECT DETAIL

SHEET TITLE ROUTE

NOT TO SCALE

TRAFFIC CONTROL PLAN